


CERTIFIED RECORD OF LAND CORNER MONUMENTATION

History of original corner establishment:

Corner was set by Mensch, U.S.G.L.O., 1906 and re-established by Douglas County, 1966.

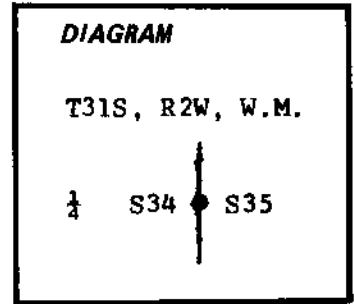


Description of corner evidence found:

Found a 1" iron pipe with a 2 1/2" brass cap marked "County Surveyors Office, 1966, T31S, R2W, 1/4, S34, S35" from which a:

- Original corner stone 12" x 8" x 6", marked "1/4", lies alongside.
- 30" Cedar original BT, healed blaze, bears S87°W, 9.9 feet.
- 20" rotten Douglas Fir stump, original BT, bears N38°E, 11.2 feet.
- 42" Douglas Fir stump, BT, scribes visible, bears N18°W, 18.6 feet (record N28°W).

Description of monument and accessories I established to perpetuate the original location of this corner:

~~None. No other trees within reasonable distance. BAS~~  
 16" Cedar BT, I scribed "1/4 S 35 BT", bears N18°E, 84 1/2 feet.  
 BAS. Sept 15, 1981

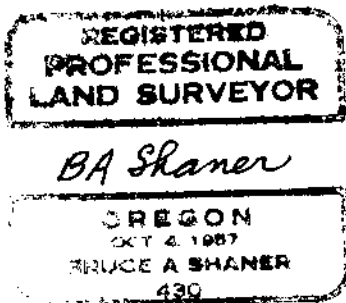

I hereby certify the above corner monument was re-established as herein described on July 23, 1980.

Office of...Surveyor..... County of...Douglas.....  
 State of...Oregon....., I hereby certify that the within instrument was filed in this office for record on the...14 day of...August....., 1980.  
 .....Francis L. Ingram..... by .....Virginia A. Langum.....  
 (COUNTY OFFICIAL) (DEPUTY)