


CERTIFIED RECORD OF LAND CORNER MONUMENTATION

History of original corner establishment:

Corner was established by William Barnes in 1972 for the U.S. Forest Service.

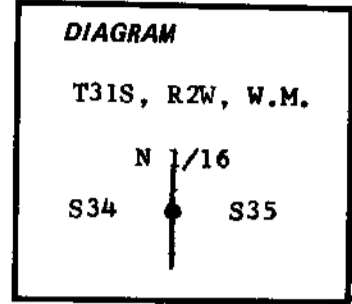

Description of corner evidence found:

Found a 2" iron pipe with a 2½" brass cap marked "T31S, R2W, N 1/16, S34, S35, 1972, PE 2128" from which a:
 20" Cedar BT, scribes visible, bears N46½°E, 18.2 feet.
 22" douglas Fir BT, scribes visible, bears N81°W, 38.0 feet.

Description of monument and accessories established to perpetuate the original location of this corner:

None.

REGISTERED
PROFESSIONAL
LAND SURVEYOR

BA Shaner

OREGON
OCT 4, 1957
BRUCE A SHANER
430

I hereby certify the above corner monument was re-established as herein described on July 24, 1980.

Office of... Surveyor County of... Douglas
 Oregon
 State of... 14 I hereby certify that the within instrument was filed in this office
 August 19 80
 for record on the... day of... 19 80

Francis L. Ingram by *Virginia A. Rauson*
 (COUNTY OFFICIAL) (DEPUTY)