


CERTIFIED RECORD OF LAND CORNER MONUMENTATION

History of original corner establishment:

Corner was originally established in 1927 as part of a Retracement and Dependent Resurvey of the Willamette Meridian by Joseph A. Ganong, U.S. Cadastral Engineer and John G. Collins, U.S. Cadastral Engineer who set an iron post, 3 ft. long, 2 ins. in the ground with Brass Cap marked "T25S R1W S12 T25S S6 S7 CC R1E 1927" from which:

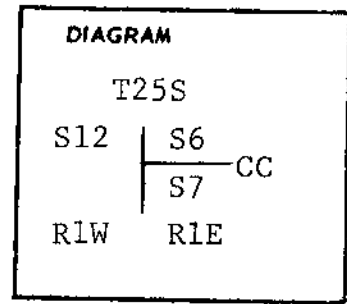


- a fir, 18" dia, bears N 61° E, 10 lks dist, mkd "T25S R1E S6 CC BT"
- a fir, 24" dia, bears S 17° E, 75 lks dist, mkd "T25S R1E S7 CC BT"

Description of corner evidence found:

US General Land Office
Survey

A 2" iron post, firmly set, 10" above the ground with a 2½" brass cap marked:

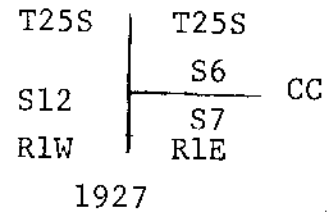

from which:

- a 21" D. fir, Orig. BT, with healed blaze, bears N 61°E, 6.6 ft.
- a 24" Wind Fallen D.fir, Orig. BT, with healed blaze bears S17°E, 49.5 ft.

Description of monument and accessories established to perpetuate the original location of this corner

a 11" D. fir, bears S7°E, 42.7 ft. marked "T25S R1E S7 CC BT" on a double blaze with a brass washer stamped "LS 536" nailed into lower blaze.

FRANCIS L. INGRAM
1/8
CLERK
DOUGLAS COUNTY



Office of Surveyor..... County of Douglas.....
State of Oregon....., I hereby certify that the within instrument was filed in this office
for record on the 5..... day of September.....1980.

Francis L. Ingram..... by *Virginia A. Lauger*
(COUNTY OFFICIAL) (DEPUTY)

149 T25-1W
151 T25-1E