


CERTIFIED RECORD OF LAND CORNER MONUMENTATION

History of original corner establishment:

Corner was originally established by Joseph A. Ganong and John G. Collins, U. S. Cadastral Engineer's under a 1928 Resurvey of T 26S, R 1 W and T 25 1/2 S, R 1 E.

The corner was perpetuated by V. R. Tracy, Douglas County Surveyor's Office in 1966, who marked a new bearing tree:

A 15" Pine bears S. 64° W., 23.6 feet.

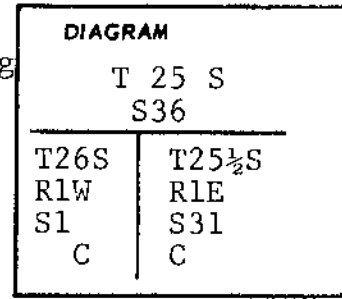


Description of corner evidence found:

3" iron post, firmly set, 10" above the ground with a 3 1/2" brass cap marked: from which original bearing trees:

A 48" fir stump, badly rotted with scribe marks "T2" visible, bears S. 31° W., 48.2 feet.

A 30" Douglas Fir, with healed blaze bears S. 36° E., 72.6 feet (Record S. 38° E., 71.9 ft.) and bearing tree marked by Tracy:

A 16" Pine snag, with scribe marks visible, on a partially healed blaze, bears S. 64° W., 23.6 feet.

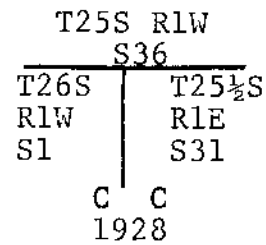

Description of monument and accessories I established to perpetuate the original location of this corner

New bearing tree:

A 20" Douglas Fir, bears S. 16° W. 17.8 feet, marked "T 26S R 1 W S1 CC BT" on a double blaze with a brass washer stamped "LS536" nailed into lower blaze.

FILED
RECEIVED *vh*
 SEP 22 1980
COUNTY SURVEYOR
DOUGLAS COUNTY, ORE.

REGISTERED
PROFESSIONAL
LAND SURVEYOR
Glenn L. Baughman
OREGON
1951
GLENN L. BAUGHMAN
536

Office of Surveyor County of Douglas
 State of Oregon , I hereby certify that the within instrument was filed in this office
 for record on the 22 day of September, 1980.
 Francis L. Ingram by *Virginia A. Langer*
(COUNTY OFFICIAL) (DEPUTY)

T25-1W #153 ✓
T26-1W #100 ✓

a