


CERTIFIED RECORD OF LAND CORNER MONUMENTATION

History of original corner establishment: This corner was originally established by Carl S. Nicklin, U. S. Deputy Surveyor, under Contract No. 664 in 1896 as the corner of Tps. 25 and 26 S., Rgs. 1 E. and 1 W. Nicklin set a 16"X12"X10" basalt stone with 6 notches on each edge, from which:

- An Alder, 12 ins. diam., bears N. 33°E., 47 lks. dist.
- A Fir, 60 ins. diam., bears S. 33° E. 72 lks. dist.
- A Fir, 12 ins. diam., bears S. 10° W., 50 lks. dist.
- A Fir, 24 ins. diam., bears N. 57° W. 80 lks. dist.

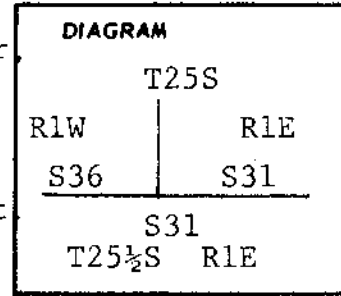

The corner was changed to refer to Tps. 25S., R. 1E. and 1W. only in a 1927 Resurvey by Joseph A. Ganong, U. S. Cadastral Engineer and John G. Collins, U. S. Cadastral Engineer, who marked the stone "25S" on the North face, "1E" on the East face and "1W" on the West face and also obliterated marks on the , S. E. and S. W. bearing trees.

Description of corner evidence found:

18"X12"X8" basalt stone with 6 notches in the North, South, East, and West faces. Stone was laying on top of the ground:

- A 62" Douglas Fir, original bearing tree, with healed blaze bears S. 36° E., 47.5 feet (Scribe marks destroyed in 1927 Resurvey).
- A 28" Douglas Fir, original bearing tree, with healed blaze bears S. 11½° E. 30.0 feet (Record 33.0 feet) (Scribe marks destroyed in 1927 Resurvey).
- A 45" Douglas Fir, original bearing tree, with healed blaze bears N. 54½°W. 52.8 feet.
- A 22" Douglas Fir, original bearing tree, with healed blaze bears N. 67½°E. 56.8 feet.
- AND a bearing tree, not of record:
- A 24" Cedar with healed blaze bears N. 32° E. 30.1 feet.

Description of monument and accessories I established to perpetuate the original location of this corner

At the corner point I set a 2½" X 30" iron pipe, 6" in the ground on bedrock in concrete, and in a 3 ft. diameter mound of stone, 3 feet high with a 3" brass cap projecting 12" above the mound of stone and marked:

T25S	
R1W	R1E
S36	S31
S31	
T 25½ S	R1 E
1980	
LS 536	

FILED RECEIVED
sh
 SEP 22 1980
COUNTY SURVEYOR
 DOUGLAS COUNTY, ORE

**REGISTERED
 PROFESSIONAL
 LAND SURVEYOR**

Glenn S. Baughman

OREGON
 JUL 24, 1961
GLENN S. BAUGHMAN
 536

Office of Surveyor County of Douglas
 Oregon
 State of , I hereby certify that the within instrument was filed in this office
 for record on the 22 day of September, 1980
 Francis L. Ingram by *Virginia A. Laugen*
 (COUNTY OFFICIAL) (DEPUTY)

*T25-1W #152 ✓
 T25-1E #42 ✓*