


CERTIFIED RECORD OF LAND CORNER MONUMENTATION

History of original corner establishment: Corner was originally established by Carl S. Nicklin, U. S. Deputy Surveyor, under Contract No. 664, in 1896 as the $\frac{1}{4}$ Section corner for Sections 36 and 31. Nicklin set a 14"X12"X10" basalt stone marked " $\frac{1}{4}$ " on the W. face from which:

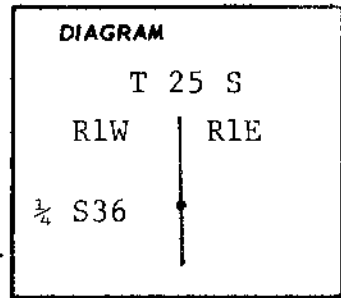

A Fir, 36 ins. diam., bears N. $80\frac{1}{2}^\circ$ W. 43 lks. dist.
An Alder, 6 ins. diam., bears N. 52° E. 14 lks. dist.

Joseph A. Ganong and John G. Collins, U. S. Cadastral Engineers, changed the corner to refer to Section 36 only in a 1927 Dependant Resurvey. They found a 6"X12"X12" basalt stone and remarked it " $\frac{1}{4}$ S36" on the W. face and marked a new bearing tree: A Fir, 8 ins. diam., bears S. 37° W. 46 lks. dist.

V. R. Tracy, Douglas County Surveyor's Office, perpetuated the corner in 1966 by setting a brass cap marked "County Surveyor's Office, T 25S, R. 1 W, $\frac{1}{4}$ S36, R1E, 1966" and marked two bearing trees:


Description of corner evidence found: 8" White Fir, S. 89° W. 12.9 feet
24" Hemlock, S. 16° W. 18.6 feet.

1" iron pipe, firmly set, 15" above the ground with a 2 $\frac{1}{2}$ " brass cap marked:

COUNTY SURVEYOR'S OFFICE
T25S

From which original bearing tree:

A 50" Douglas Fir stump, with scribe mark "4" visible, bears N. $80\frac{1}{2}^\circ$ W. 28.4 feet.

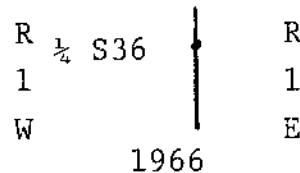

And bearing trees marked by V. Tracy, Douglas County Surveyor's Office:

A 8" Douglas Fir snag, with scribe marks " $\frac{1}{4}$ S36 CS BT" visible on an unhealed blaze bears S. 89° W., 12.9 feet.

A 24" Hemlock snag, with scribe marks, " $\frac{1}{4}$ S36 CS BT" visible on an unhealed blaze bears S. 18° W. 18.6 feet.

Description of monument and accessories established to perpetuate the original location of this corner (Record 16° W)

New bearing trees:

A 10" Cedar, bears S. 52° W. 33.8 ft. marked: " $\frac{1}{4}$ S36 BT" on a double blaze with a brass washer "LS 536" nailed into lower blaze.

A 16" Douglas Fir, bears N. 38° W. 61.3 feet marked, " $\frac{1}{4}$ S36 BT" on a double blaze with a brass washer "LS 536" nailed into lower blaze.

FILED
RECEIVED *jh*
SEP 22 1980
COUNTY SURVEYOR
DOUGLAS COUNTY, ORE

REGISTERED
PROFESSIONAL
LAND SURVEYOR

Glenn S. Baughman

OREGON
JULY 14, 1981
GLENN S. BAUGHMAN
536

Office of Surveyor..... County of Douglas.....

State of Oregon....., I hereby certify that the within instrument was filed in this office

for record on the 22 day of September, 1980

Francis L. Ingram
(COUNTY OFFICIAL)

by *Virginia A. Langen*
(DEPUTY)

T25-1W #158 X
T25-1E #43 X