


**SURVEY OF 1/2 OF WEST LINE,
SECTION 8, T29S, R6W, W.M.**

FILED ✓
RECEIVED *BS*

FOR: CALVIN SCHIERMEISTER
BY: AA SURVEYING SERVICE, INC.
P.O. BOX 130
ROSEBURG, OR. 97470

APR 28 1983

COUNTY SURVEYOR
DOUGLAS COUNTY, ORE.

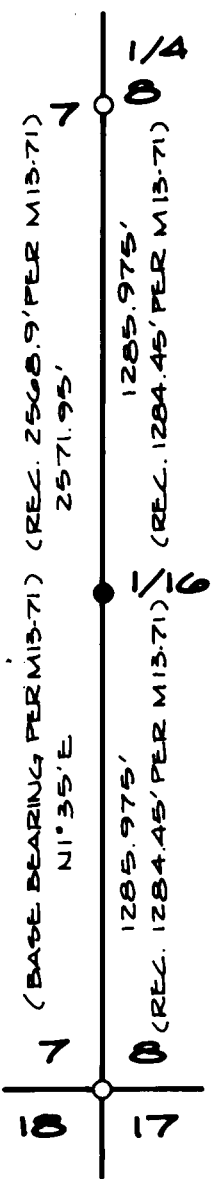

1/4 CORNER:
FD. 2 1/2" IRON POST W/BRASS CAP MKD. AS SHOWN.
BT'S FOUND:
12" FIR SNAG, NOW ROTTED, BEARS S69°E 37.6'
15" FIR BEARS S72 1/2°W 25.7' (REC. 38 LKS) HEALED BLAZE
17" FIR BEARS N7°E 68.6' (REC. 101 LKS) HEALED BLAZE

**COUNTY SURVEYORS FILE DATA
DO NOT REMOVE FROM OFFICE**

5/16 CORNER:
SET 2 1/2" x 30" ALUM. PIPE 24" IN THE GROUND
WITH 2 1/2" CAP MARKED AS SHOWN:
SCRIBED NEW B.T.'S:
12" OAK BEARS N48°W 29.1' MKD. "5/16 S7 BT"
15" FIR BEARS S34°E 16.4' MKD. "5/16 S8 BT"

SCALE: 1" = 500'
APRIL 1983

SECTION CORNER:
FD. 2 1/2" IRON POST W/BRASS CAP MKD. AS SHOWN.
BT'S FOUND:
30" MADRONA BEARS S17°W 10.6' TO FACE (ORIG. BT.)
10" FIR (BLOW DOWN) BEARS N12°E 54.1' VIS. SCRIBE
12" FIR BEARS S66°E 61.2' (REC. 100 LKS) HEALED FACE
14" FIR BEARS S78°W 33.0' HEALED FACE
8" FIR SNAG, 6.0' HIGH, BEARS N83°W 53.1' (REC. 84 LKS) -
HEALED FACE

LEGEND:

- - FOUND 2 1/2" IRON POST WITH BRASS CAP & BEARING TREES
- - SET 2 1/2" x 30" ALUM. PIPE WITH 2 1/2" CAP

NARRATIVE:

PURPOSE:

TO MARK THE 1/2 OF THE 1/2 OF THE WEST LINE OF SECTION 8, AND SET THE 5/16 CORNER.

PROCEDURE:

I MADE A DILIGENT SEARCH FOR THE 5/16 CORNER THAT WAS SET IN 1917 PER M13-71. NO EVIDENCE OF THE CORNER OR BEARING TREES WAS FOUND. I THEN RAN A RANDOM LINE BETWEEN THE S.W. CORNER OF SECTION 8 AND THE 5/16 CORNER. FROM THIS I REESTABLISHED THE 5/16 CORNER.

EQUIPMENT:

TOPCON GTS-2.

REGISTERED
PROFESSIONAL
LAND SURVEYOR

Eugene A. Bloom

OREGON
MAY 13, 1960
EUGENE A. BLOOM
492

58/242 -2