

SURVEY IN LOT 97 MELROSE ORCHARDS
 in the NE 1/4 Sect. 35, T.26 S., R.7 W., W.M.
 Surveyed for Richard Johnson by Landline
 Development Company
 July, 1981

Scale 1" = 100'

FILED ✓
 RECEIVED ✓/L


JUL 13 1981

- Found 5/8" Iron Rod
- Found 3/4" Iron Rod
- Set 5/8" x 30" Iron Rod

COUNTY SURVEYORS FILE DATA
DO NOT REMOVE FROM OFFICE

COUNTY SURVEYOR
 DOUGLAS COUNTY, ORE.

✓

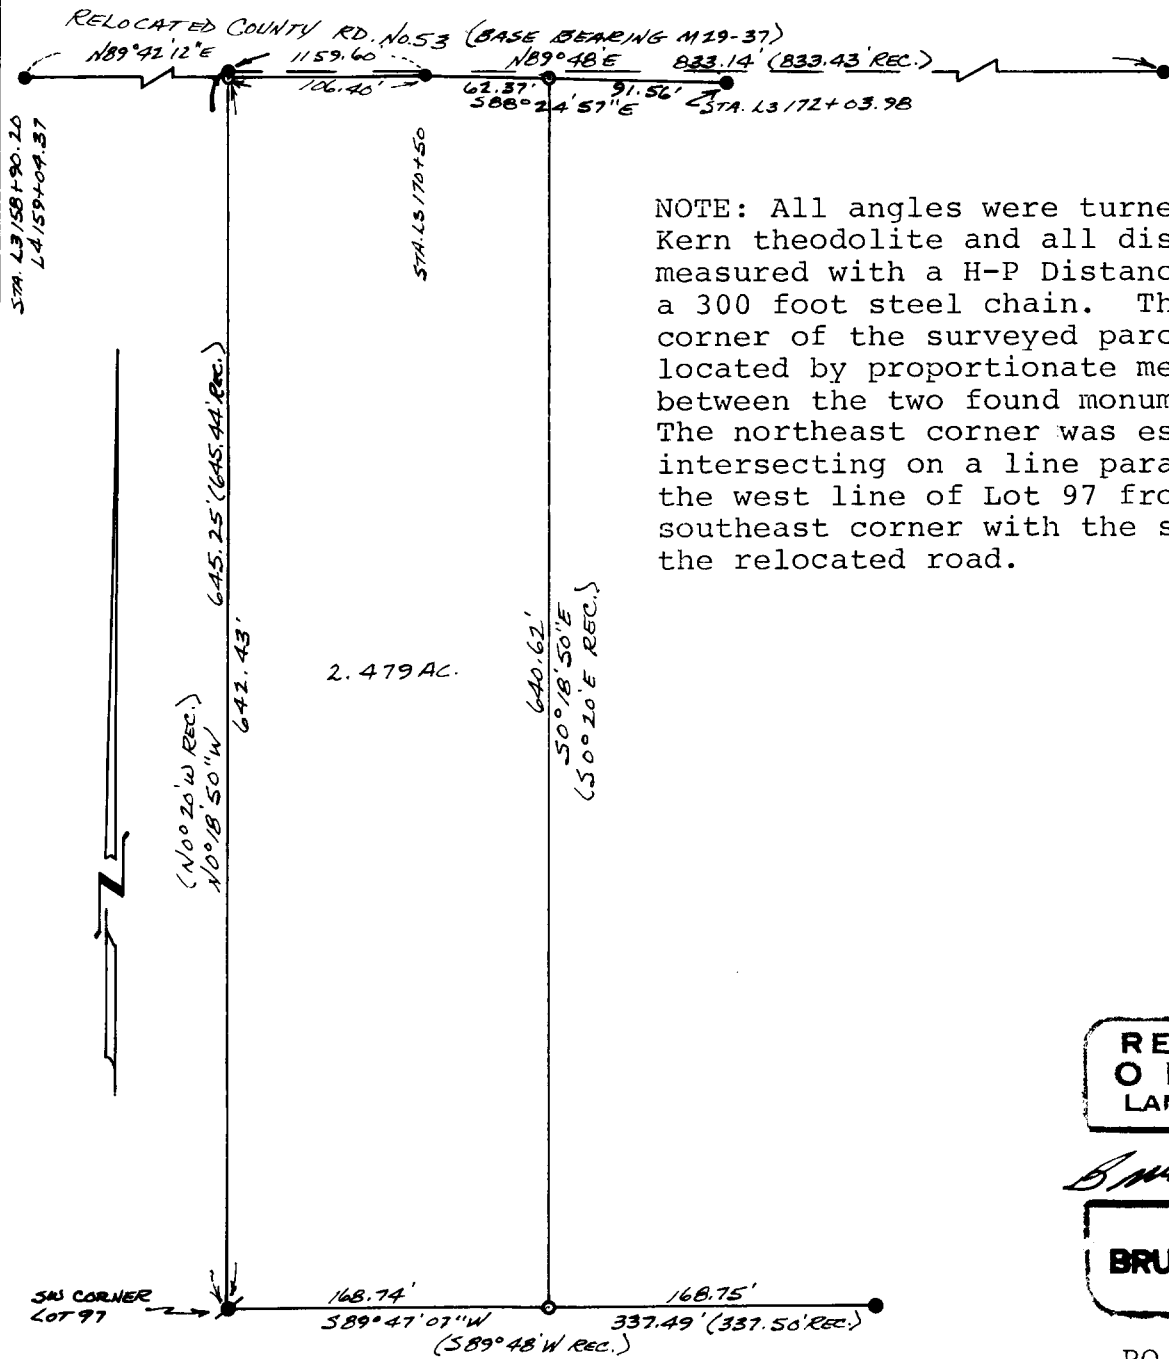

NOTE: All angles were turned with a 20" Kern theodolite and all distances were measured with a H-P Distance Meter and a 300 foot steel chain. The southeast corner of the surveyed parcel was located by proportionate measurement between the two found monuments shown. The northeast corner was established by intersecting on a line parallel with the west line of Lot 97 from the new southeast corner with the south line of the relocated road.

REGISTERED
 OREGON
 LAND SURVEYOR

Bruce R. Rogers

JULY 10, 1964
 BRUCE R. ROGERS
 660

PO Box 2191
 Roseburg, Or.

S. File No. 58/244-2