


FILED *BS*  
RECEIVED *HL*

DEC 6 1982  
COUNTY SURVEYOR  
DOUGLAS COUNTY, ORE.

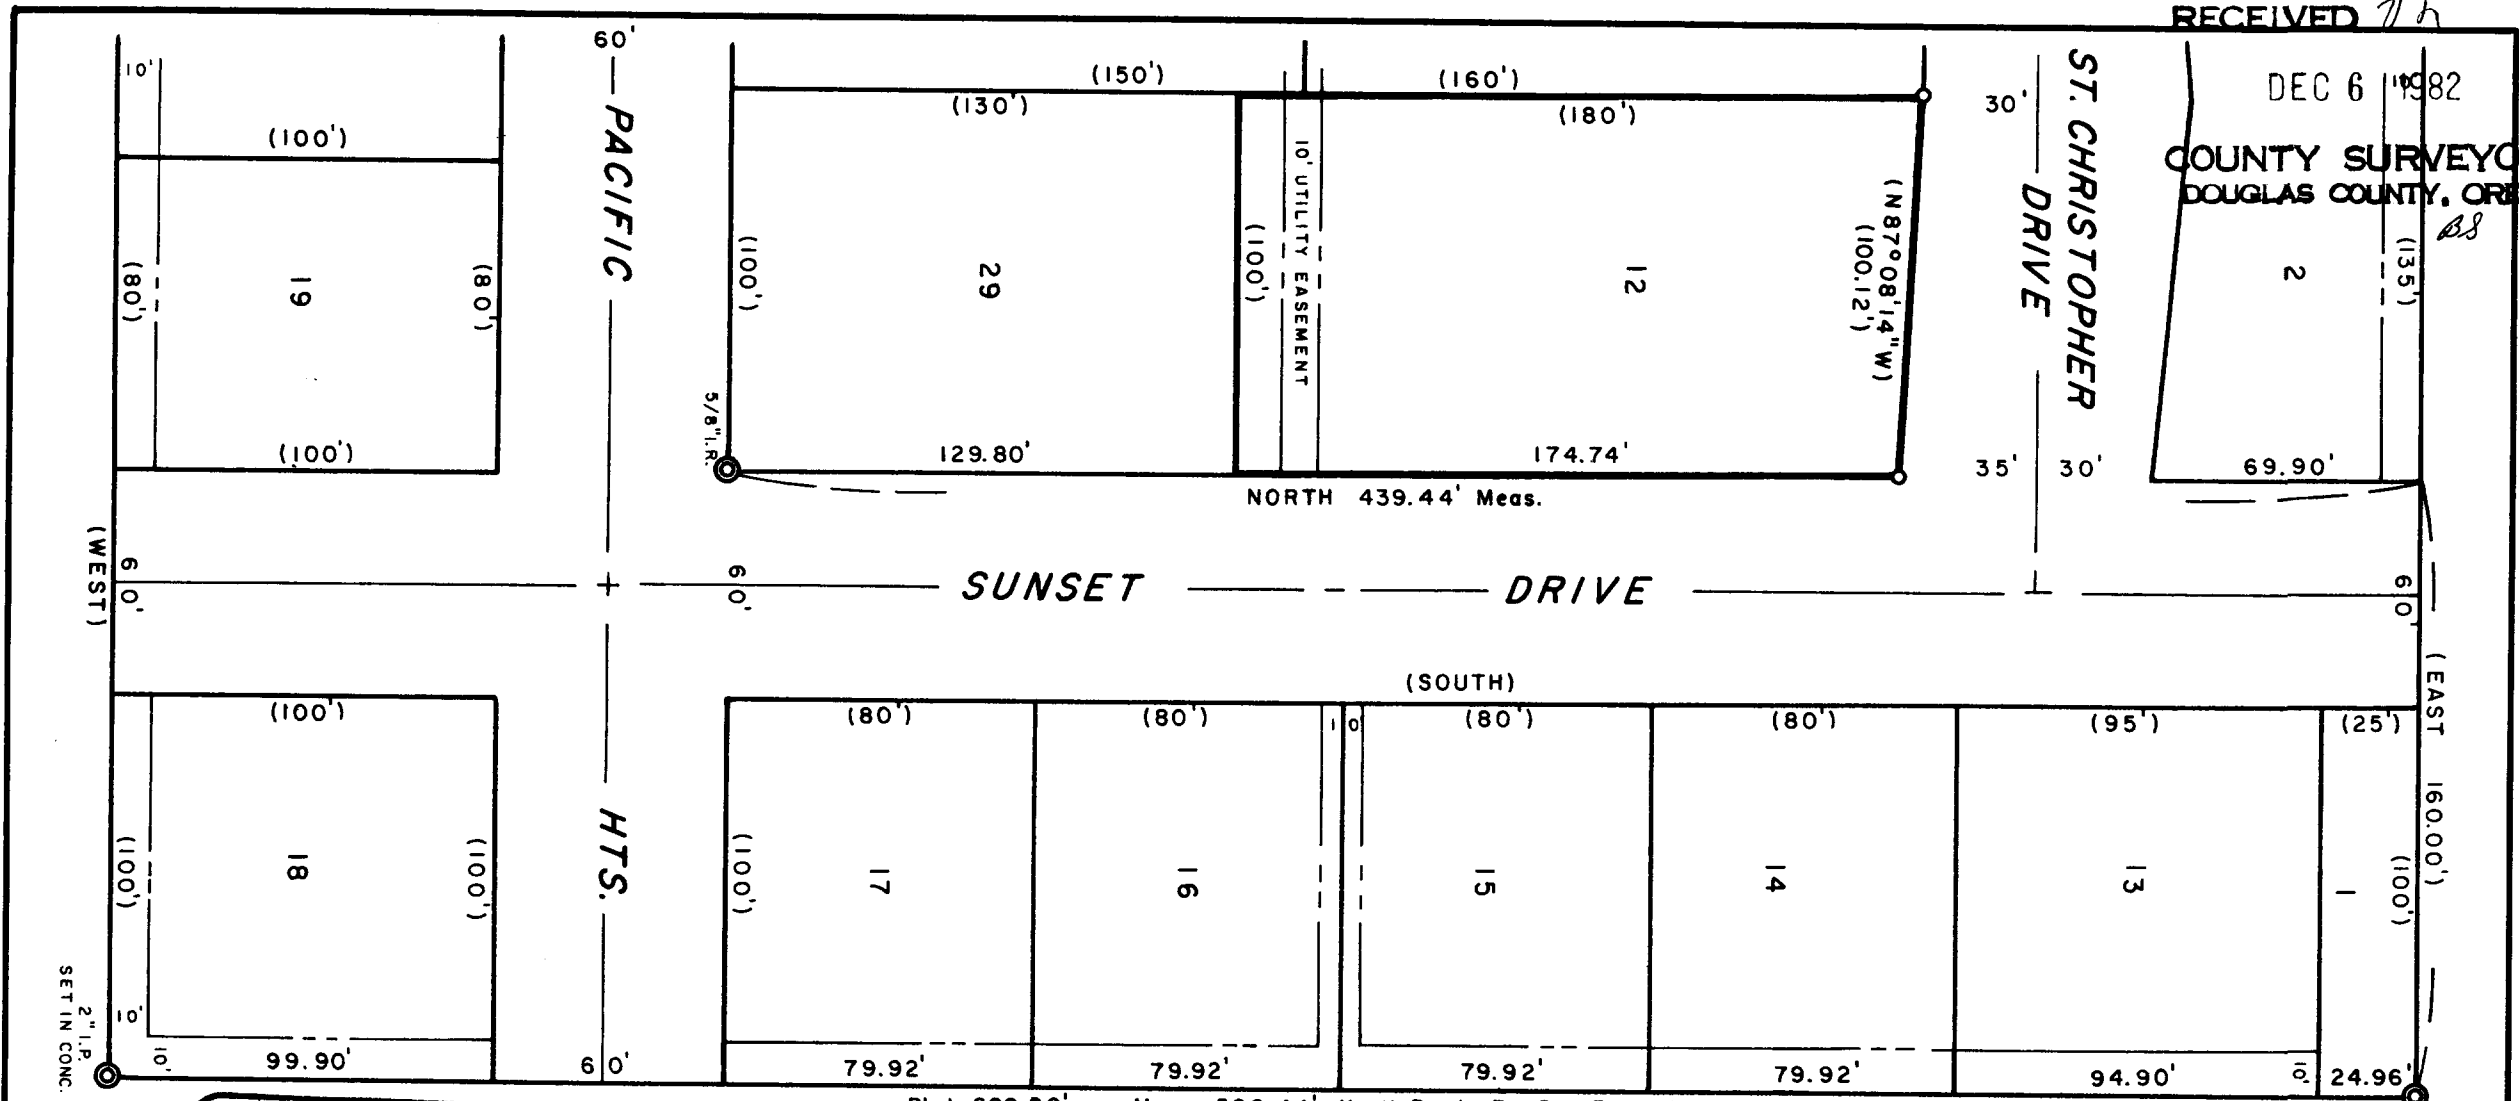

**REGISTERED  
PROFESSIONAL  
LAND SURVEYOR**

*Richard J. Hintz*

OREGON  
MAY 13, 1966  
RICHARD J. HINTZ  
497

RICHARD J. HINTZ  
1890 N. 14th ST.  
COOS BAY, OREGON

CORNERS FND. (ORIGINAL PLAT MONUMENTS) ●  
SET 5/8 x 36" I.R.'S/ STAMPED CAPS ○  
(DENOTES PLAT DIST. & BRG.) R.J. HINTZ P.L.S. 497

**COUNTY SURVEYORS FILE DATA  
DO NOT REMOVE FROM OFFICE**

**PROPERTY SURVEY  
FOR  
BOB HASTIE**

LOT 12 - PACIFIC HEIGHTS  
NW 1/4 NE 1/4, SEC. 7, T 22 S, R 12 W  
DEC. 1982 SCALE 1" = 50'

