


PROPERTY SURVEY FOR INTERNATIONAL PAPER CO.

FILED *d*
RECEIVED *HR*
AUG 16 1984
COUNTY SURVEYOR
DOUGLAS COUNTY, ORE.
d

SECTION 21, T21S, R11W
AUGUST 1984 SCALE 1" = 400'

**COUNTY SURVEYORS FILE DATA
DO NOT REMOVE FROM OFFICE**

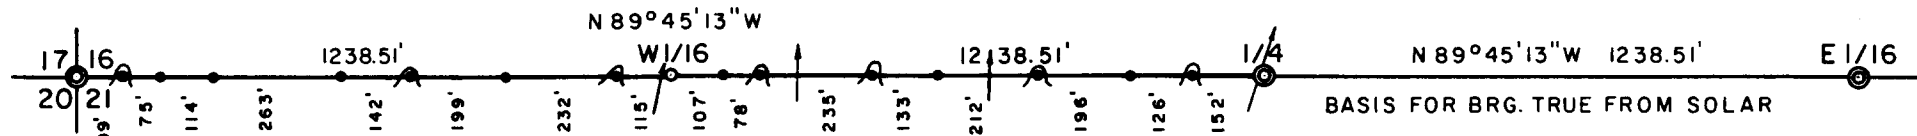

I.P./B.C., D.C. 1970
From Which:
66" CEDAR BRS. N 65° E, 66.0' (face) Original
110" FIR BRS. S 12° E, 6.3 (face) 1918
36" HEMLOCK BRS. S 33° W, 10.9', 1970
48" HEMLOCK SNAG BRS. N 77° W, 21.7', Original
74" CEDAR BRS. N 29° W, 33.5', 1970

12" ALDER BRS. N 88° 00' E, 12.3' Scribed
12" ALDER BRS. S 58° 45' W, 16.9'

5/8" I.R. / CAP, R.J. HINTZ P.L.S. 497
From Which:
28" CEDAR STUMP BRS. N 77° 19' E, 57.87'
22" HEMLOCK BRS. N 46° W, 66.0'

I.P./B.C., P.L.S. 497 1982
From Which:
14" HEMLOCK BRS. S 66° 30' E, 39.6'
60" FIR STUMP BRS. S 85° W, 7.3'

I. P.

LEGEND

CORNERS FOUND SET 1 1/4 x 36" I.P. / STAMPED BRASS CAP (P.L.S. 497)
PROPERTY LINE ESTABLISHED, 1/2 x 60" I.R.'S / ATTACHED ALUMINUM SIGNS

W1/16 CORNER SET BY SINGLE PROPORTIONATE MEASUREMENT.
DISTANCES TAKEN TO A 50 d NAIL IN THE CENTER OF EACH BEARING TREE.

**REGISTERED
PROFESSIONAL
LAND SURVEYOR**

Richard J. Hintz

**OREGON
MAY 13, 1980
RICHARD J. HINTZ
497**

1890 N. 14th ST.
COOS BAY, OREG.

