

M 94-75 A:B

UMPQUA SURVEYING COMPANY

P. O. Box 791
Myrtle Creek, Oregon 97457

626 N.E. Division Street
Telephone (503) 842-5101

RECEIVED *JK*

SEP 13 1983

SURVEY NARRATIVE
SEPTEMBER 1983

COUNTY SURVEYOR
DOUGLAS COUNTY, ORE.

SURVEY FOR: Kip D. and Casey J. Morgan

LOCATION: NE $\frac{1}{4}$ and SE $\frac{1}{4}$, S22, T29S, R5W

PURPOSE: A new parcel for industrial use was created. The descriptions of easements were also prepared.

BOUNDARY CONTROL: All boundaries of Parcel 1 are newly created except County Road Right-of-Way as shown.

BASIS OF BEARING: A solar observation was taken near the NW corner or Parcel 1.


EQUIPMENT: Leitz T60D Theodolite, Mac II EDM, 100' Steel Tape, Lietz B-2 Automatic Level, and 13 Foot Rod.

LEVEL DATUM: Levels based on BM L-128⁶ on Myrtle Creek Bridge, Main Street, Myrtle Creek. Elevation 608.218. *426*

BENCH MARK MM: Poured reinforced concrete 8"x36". Top of concrete 10"x10" with 1 $\frac{1}{2}$ " brass cap installed. Cap marked:

OLD DATUM
10-7-88
WJR
MAP
CORRECTED

MM
LS 866
1983

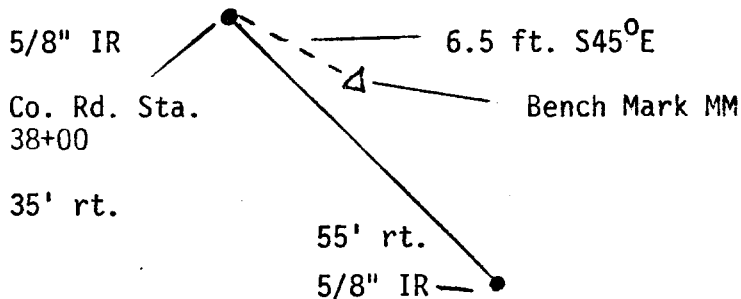

Copies of level notes attached.

REGISTERED
OREGON
LAND SURVEYOR

William J. Ruppert
JULY 12, 1968
WILLIAM J. RUPPERT
866

G & E No. 58/270-6