


PUBLIC LAND CORNERS

RECEIVED
 SEP 28 1982
 COUNTY SURVEYOR
 DOUGLAS COUNTY, ORE

Weyerhaeuser Company
 Springfield Branch

TOWNSHIP 23 South RANGE 2 West
 SECTION 34 CORNER W 1/4
 COUNTY Douglas OREGON

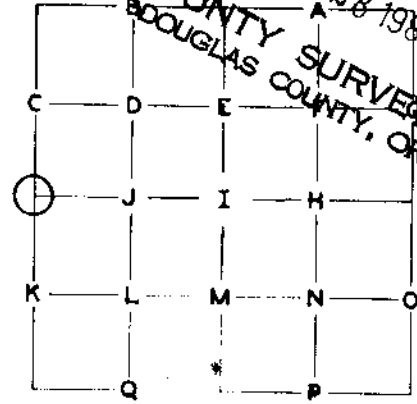

GLO SURVEY RECORD

DATE: 1894

CORNER

PRESENT CONDITION - (DESCRIBE FULLY - USE PAGE 2 IF NEEDED FOR EXPLANATION.)

As of 5-13-82

ACCESSORIES:

	BEARING-	LINKS-	FEET-
12" hemlock	S 30 E	---	21.8
36" fir	N 72 W	---	25.1

Open face - scribing - 30" hemlock
 46" fir - face grown over

Douglas County **SURVEY RECORD**
 DATE: 1969

PRESENT CONDITION: 5-13-82

- 1) 30" hemlock S 30 E 21.8 feet
- 2) 16" hemlock S 20 W 46.3 feet
- 3) 46" fir N 70 W 26.0 feet

Douglas County Tag - scribing visible
 Douglas County Tag - scribing visible - face open
 BLM Tag - face grown over


CORNER SET: Douglas County brass cap

MAG. DECL.:

BEARING AND DISTANCE TO ABOVE IDENTIFIED SURVEY ACCESSORIES:

BEARING-	FEET-	SURVEY-	
N 70 W	26.0	1894	Center tree measurement

SECTION 34 TOWNSHIP 23 South RANGE 2 West

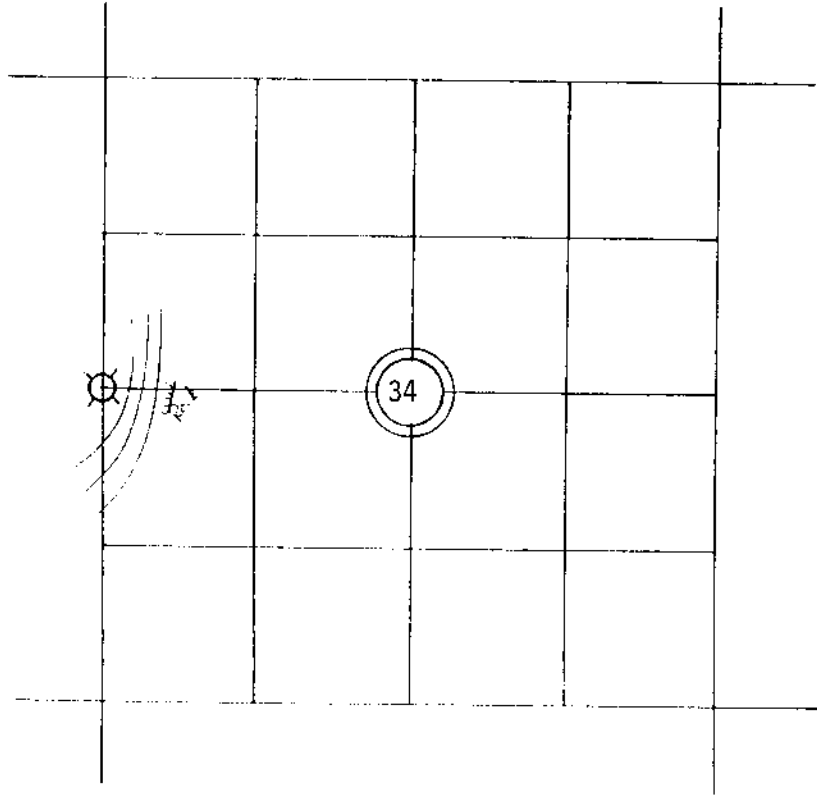

---//---//---//--- LINE MARKED BY NOTCH CUT IN BLAZE.

○... KNOWN CORNER.

⊗... REFERENCED CORNER BY WEYERHAEUSER METHOD.

Multiple horizontal lines for handwritten notes or measurements.

SB/271-1

ACCESSORIES ADDED THIS DATE: 5-13-82

MAGNETIC DECLINATION 20° E

	BEARING	FEET	ORIG. B.T.	"W" NAIL	PLATE	BRASS DISC
60" fir	S 25½ W	40.3	---	X	X	---
30" hemlock	S 31 E	20.3	X	X	X	---

IDENTIFIED ON PHOTO:

INFORMATION ON LOCATION OF CORNER AS NOW SET:

GROUND COVER: Old growth fir, vine maple

(USING FORM LINES SKETCH TOPOG AT CORNER ON PAGE 2 PLAT)

SLOPE FACES (GIVE BEARING IN DEGREES) N 70 W ON MINUS (-) 60 %

NORTH: -30%

SOUTH: +25%

EAST: +60%

WEST: -60%

WORK DONE FOR W. CO.

FIELD NOTES IN BOOK:

BY: Helmut Kreidler DATE: May 13, 1982
ENGINEER - SURVEYOR

ASSISTED BY: Ken Perkins

UNDER THE SUPERVISION OF:

COPIES SENT TO:

58/271-1 SEAL

36	31	32	33	34	35	36	31
1	6	5	4	3	2	1	6
12	7	8	9	10	11	12	7
13	18	17	16	15	14	13	18
24	19	20	21	22	23	24	19
25	30	29	28	27	26	25	30
36	31	32	33	34	35	36	31
1	6	5	4	3	2	1	6

WEYERHAEUSER COMPANY

CORNER REFERENCE METHOD CONSISTS OF:

A "W" NAIL DRIVEN THRU THE HOLE IN A BRASS DISC, INTO A NOTCH CUT LOW ON A TREE, STAMPED WITH THE OREGON REGISTERED LAND SURVEYOR OR PROFESSIONAL ENGINEER REGISTRATION NUMBER.

AN EMBOSSED ALUMINUM PLATE, NAILED HEAD HIGH ON SAME TREE WITH 8D ALUMINUM NAILS, WITH DISTANCE AND BEARING FROM THE "W" NAIL TO THE CORNER STAMPED ON IT.

