




Weyerhaeuser Company

Section 28

Township 27 So.

Range 8 W.

RESTORED CORNER for WEYERHAEUSER Co.

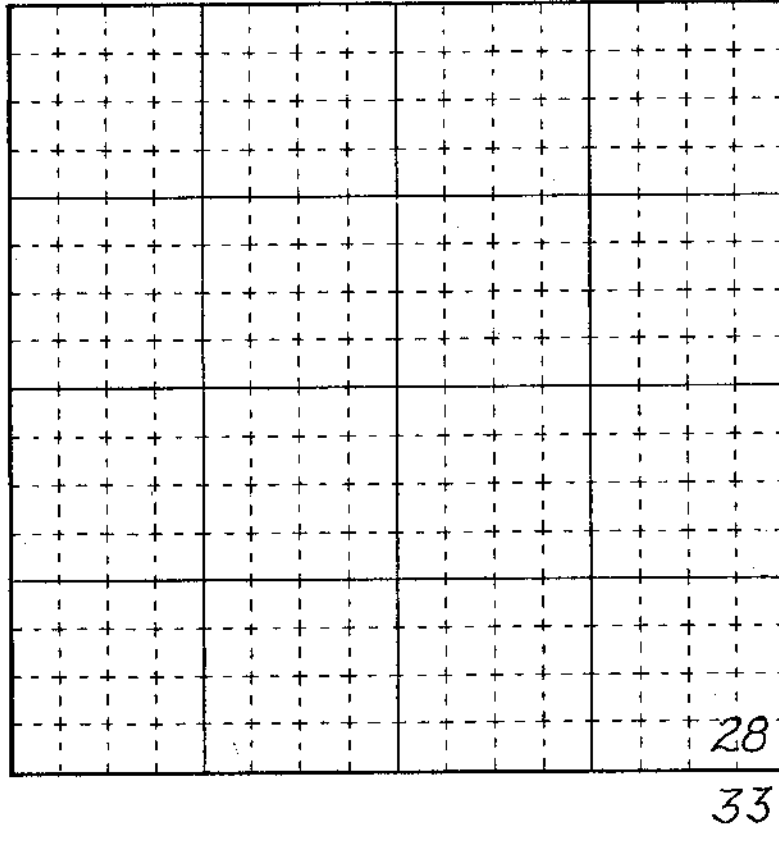

REGISTERED
PROFESSIONAL
LAND SURVEYOR


Craig L. Templin

OREGON
JULY 17, 1970
CRAIG L. TEMPLIN
938

Found:

60" fir OBT (now rotted snag) - scribing visible - S 58° W 138 lks.
18" fir OBT (windthrown) - face evident - N 82° E 170 lks.

SET 2" iron pipe with brass cap marked:

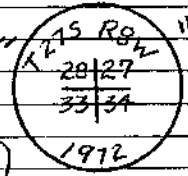

MARKED NEW B.T.s as follows:

4" incense cedar N 22° W 13.1 ft.
6" chinquapin N 42° E 27.3 ft.
8" fir S 66° W 27.9 ft.
4" fir S 43° E 14.4 ft.

marked "S T27SRBW BT"

placed Weyco tags and "W" nails on all new B.T.s.

January 16 1973

Craig L. Templin

#71X