

SURVEY IN LOTS 23 & 24,

EAGLE POINT ESTATES (VOL. 13, PG. 23)

LYING IN NW 1/4, SECTION 19, T26S, R4W, W.M.

FILED
RECEIVED

FOR: EDNA STRADER
BY: BHW ENGINEERING, INC.
1205 S.E. COURT
ROSEBURG, OREGON

COUNTY SURVEYOR
DOUGLAS COUNTY, ORE.

SCALE: 1" = 100'

APRIL 1982

BS

NARRATIVE:

SURVEY TO SET MONUMENTS BETWEEN LOTS 23 & 24.
LINE ESTABLISHED BY PROPORTIONING THE BEARING
BETWEEN THE TWO KNOWN LOT LINES.


FIELD CREW: R. QUIMBY & G. LANG.

EQUIPMENT: WILD T-1 THEODOLITE MOUNTED WITH LEITZ
RED-1 E.D.M.

OFFICE COMPUTATIONS: R. WARE.

DRAFTING: D. HOPKINS.

**COUNTY SURVEYORS FILE DATA
DO NOT REMOVE FROM OFFICE**

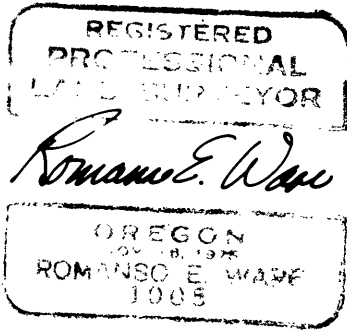

LEGEND

- - SET 5/8" ^{x 30"} IRON ROD WITH CAP MARKED "BHW, INC."
- - FOUND 5/8" IRON ROD UNLESS NOTED OTHERWISE

