

**SURVEY IN LOT 10, BLOCK 4,  
"WAREWOOD VALLEY"**

LYING IN N 1/2, SECTION 11, T27S, R6W, W.M.

FOR: RICHARD SCHACHT & BUZZ DESBIENS

BY: ROMNEY WARE, L.S.  
2771 N.W. GARDEN VALLEY RD.  
ROSEBURG, OREGON

BS

COUNTY RECORDS


SCALE: 1" = 50'      OCTOBER 1983

**COUNTY SURVEYORS FILE DATA  
DO NOT REMOVE FROM OFFICE**

REGISTERED  
PROFESSIONAL  
LAND SURVEYOR

*Romney E. Ware*

OREGON  
NOV 16, 1978  
ROMANEO E. WARE  
1005

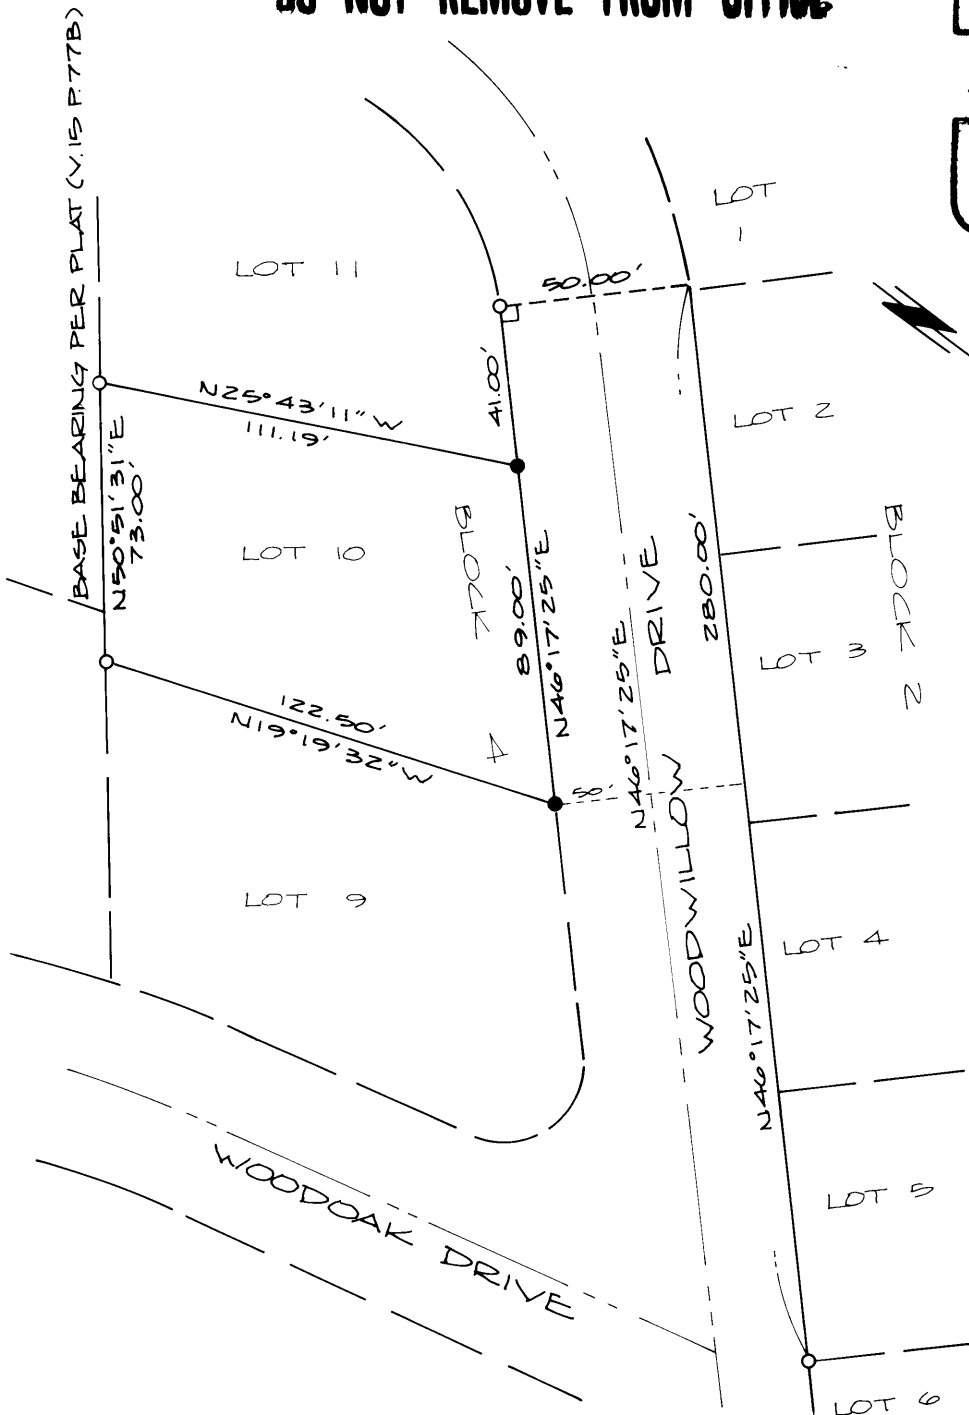

**LEGEND:**

- - FD. 5/8" IRON ROD
- - SET 5/8" x 30" IRON ROD W/CAP MKD. "RE. WARE-LS1005"

**NARRATIVE:**

SURVEY TO REPLACE FRONT MONUMENTS OF LOT 10, BLOCK 4, "WAREWOOD VALLEY".

ALL MEASUREMENTS SHOWN ARE RECORD PER ORIGINAL PLAT.

FIELD CREW: R. WARE & M. RIGGAN. EQUIPMENT: K & E PARAGON & CHAIN. DRAFTING: D. HOPKINS.