

R. M. 3-61

Mail:
1140 ACACIA LANE
GRANTS PASS, OR 97527

ROBERT M. THOMPSON
Consulting Engineer, Surveyor, Forester

FILED TELEPHONE 476-3269
RECEIVED BS

Office:
233 N. E. "B" STREET

JUL 30 1984

COUNTY SURVEYOR
DOUGLAS COUNTY, ORE.

SURVEY TO SET & MARK CERTAIN BOUNDARIES & CORNERS
IN SECTION 5, T33S, R6W, W.M.

DOUGLAS COUNTY, OREGON

April 14, 1984
June 22, 1984

Narrative Description to comply with Par. 209.250, O.R.S.

Purpose: As stated above

NOTE: 1 Map sheet accompanies this
survey narrative.

By: Robt. M. Thompson & Assoc., 1140 Acacia Ln., Grants Pass, OR. 97527

For: Phillip E. Palm, P.O. Box 40 Section Creek, Glendale, OR. 97442
Daniel O. Johnson, P.O. Box 50 Section Creek, Glendale, OR. 97442

Procedure:

Survey and corner information was researched at the Douglas County Surveyor's office. No recorded surveys were found in the interior of Section 5, except for boundaries and within the City of Glendale (formerly "Town of Julia"), occupying most of the NE $\frac{1}{4}$. Additionally, a check of former Robert Dollar Co. survey records, by personnel of Gregory Timber Resources Inc., yielded no additional survey information. Using electronic distance measurements with a one-second theodolite, my survey tied in all exterior Government corners that were needed for the required Section subdivision work. Cross-checks were made as deemed necessary. The $\frac{1}{4}$ Corner for Sections 5/8 was not found, despite diligent search, and had not been found in previous searches by the Douglas County Surveyors personnel and the Robert Dollar Co. In computing the subdivision of Section 5, the proportioned position for said $\frac{1}{4}$ corner was used.

The required boundaries and additional corners were then surveyed, set and marked as shown on my map. Survey No. M22-50 surveyed the alleged west line of the City of Glendale in 1963. Monuments set on said line, in this and later surveys, fall to the west of the computed true North-South center line, as shown on my map.

Corners found or set are as follows. Bearing trees were measured to centers, and original Govt. bearing trees (O.B.T.'s) were measured to the face positions, unless noted otherwise:

C.S. File No. 58/275 SA (N)

SURVEY TO SET AND MARK CERTAIN BOUNDARIES & CORNERS
IN SECTION 5, T33S, R6W, W.M.

RECEIVED *BS*

JUL 30 1984

- North $\frac{1}{4}$ Cor. Section 5 only, C.S. File ~~42/354~~ ^{54/53 8/1/84}, found $\frac{1}{2}$ " COUNTY SURVEYOR
DOUGLAS COUNTY, ORE.
- ✓ Eye Bolt & B.T.'s:
18" Fir stump S 25°E 6.6', rotted face, O.B.T.
14" D. Fir S 27°E 13.2', healed
16" D. Fir S 52°W 14.3', healed
- Standard North Cor. Sections 6 & 5 only, C.S. File ~~54/53~~ ^{42/354 8/1/84}
found 1" I. Rod & B.T.'s:
✓ 24" Fir stump S 68°E 51.7', rotted w/"BT" scribe vis., O.B.T.
18" Fir S 23°30'E 38.8', healed
42" Fir S 51°W 62.8', windthrown, scribe vis.
- South Cor. Sections 31 & 32 only, C.S. File 42/354, no mon.
found, only B.T.'s:
✓ 12" Madrone N 26°30'W 18.1', healed
10" Madrone N 28°30'E 32.3', scribe part vis.
- $\frac{1}{4}$ Corner Sections 6 & 5, found O.S.B.F. 1964 brass cap on $1\frac{1}{2}$ "
G.I. Pipe, 4"x4" White Post alongside, & B.T.'s, C.S. File 51/264:
30" Madrone N 80°W 11.9', 1964 rescribe vis., O.B.T.
✓ 16" Chinquapin S 21°E 10.6', scribe vis.
56" Fir stump N 68°W 32.2' to face, scribe vis.
Cor. is $\pm 45'$ South of old logg.rd., brs. E'ly & W'y.
- Cor. Sections 5,6,7,8, found Co. Surv. 1963 brass cap on 1" G.I.
Pipe, and Co. Surveyor B.T.'s, C.S. File 53/8:
✓ 8" Madrone broken stub S 20°W 7.5', scribe vis.
15" Madrone S 10°E 8.2', healed
22" D. Fir S 80°E 76.9', healed
Cor. is $\pm 60'$ South of creek, brs. SE'ly.
- Cor. Sections 4,5,8,9, found B.L.M. 1963 brass cap on 2" G.I.
Pipe, & B.T.'s per B.L.M.:
✓ 26" I. Cedar snag N 8°E 15.8' scribe part vis., O.B.T.
24" D. Fir stump S 40°E 26.7' rotted, O.B.T.
16" I. Cedar snag N 23°W 9.2', down, O.B.T.
14" P. Pine N 25°E 33.2', healed
9" D. Fir S 13°E 20.2', healed
12" P. Pine S 34°W 19.1', healed
10" D. Fir N 45°W 16.0', healed
24" I. Ced. S 84°W 17.0', healed
- $\frac{1}{4}$ Corner Sections 5 & 4, found 2" G.I. Pipe & B.T.'s
C.S. File 52/137:
✓ 22" D. Fir S 41°04'E 29.8', healed
15" Alder S 32°20'W 35.5', healed, partly rotted

RM 3-61

PAGE 3

FILED
RECEIVED *BS*


SURVEY TO SET AND MARK CERTAIN BOUNDARIES & CORNERS
IN SECTION 5, T33S, R6W, W.M.

JUL 30 1984


COUNTY SURVEYOR
DOUGLAS COUNTY, ORE.

Northwest 1/16 Cor, set 5/8" x 30" I. Rod w/yel. cap, scribed B.T.'s "NW1/16S5 1358 BT" on:
17" D. Fir N 19°W 9.9'
11" D. Fir S 72½°E 7.5'

Center North 1/16 Corner, set 5/8" x 30" I. Rod w/yel. cap,
scribed B.T.'s "CN1/16S5 1358 BT" on:
9" D. Fir N 59½°E 20.9'
18" D. Fir S 15½°E 23.6'

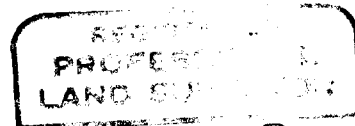

Robert M. Thompson

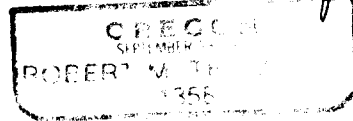

C.S. File No. 58/275 - 50 (N)