

**PROPERTY SURVEY IN OAK KNOLLS
ESTATES FOR LOT 28 IN THE N.E. 1/4
SECTION 30, T26S., R5W., W.22
DOUGLAS COUNTY, OREGON**

**FILED CMO
RECEIVED** *SL*

APR 19 1985

**COUNTY SURVEYOR
DOUGLAS COUNTY, ORE.**

CMO

FOR: WAYNE SPICER

Legend:


- FD. 5/8" IRON ROD
- SET 5/8" X 30" IRON ROD/CAP (107)

BY: ROBERT L. DOLAN
RT. 1, BOX 1820
SUTHERLIN, OREGON 97479

**COUNTY SURVEYORS FILE DATA
DO NOT REMOVE FROM OFFICE**

DATE: APRIL, 1985

SCALE: 1"=50'

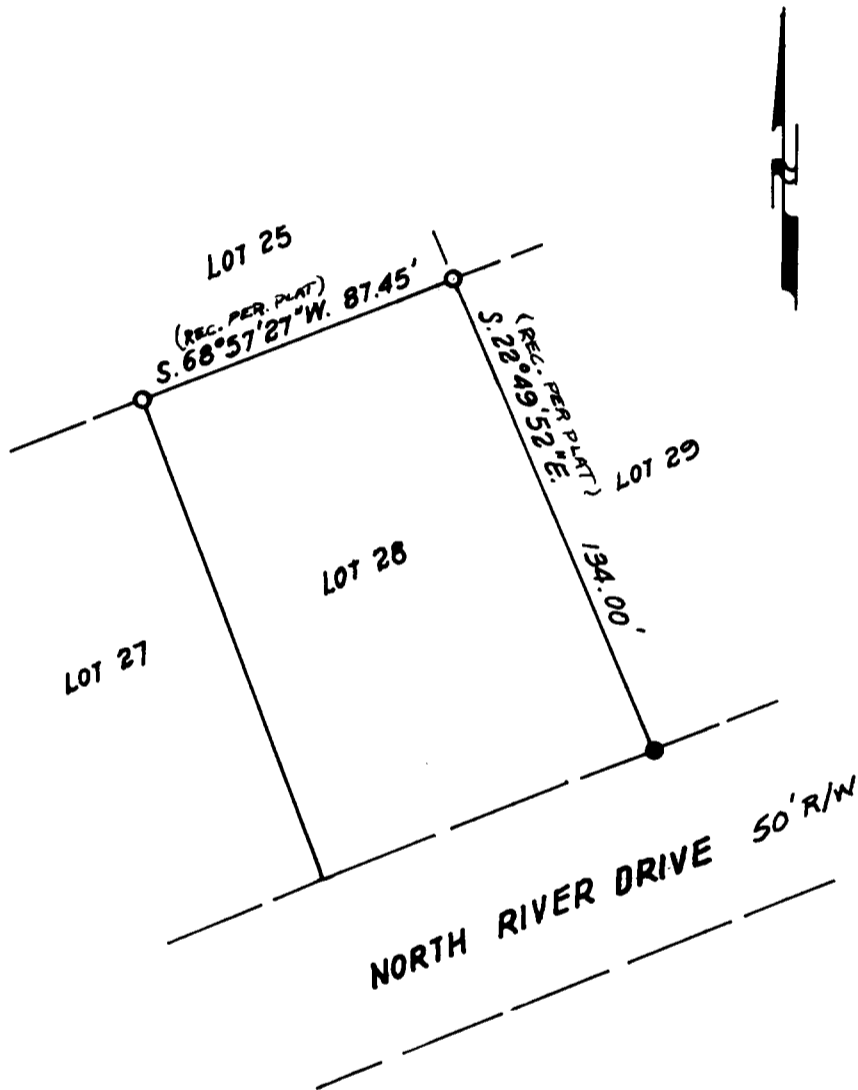

NARRATIVE: SURVEY TO RESET PROPERTY CORNER LOST DURING UNDERGROUND POWER INSTALLATION. PIN RESET FROM FOUND EXISTING CORNERS.

INSTRUMENTS: THEODOLITE - CHAIN

REGISTERED
PROFESSIONAL
LAND SURVEYOR

Robert L. Dolan

OREGON
JULY 30, 1976
ROBERT L. DOLAN
1076