

M 96-24

FILED  
RECEIVED *BJ*

OREGON CORNER RESTORATION FORM

MAR 28 1984

Section 21 Township 22S Range 9W

COUNTY SURVEYOR  
DOUGLAS COUNTY, ORE.

County Douglas Date 4-01-83

Corner Designation

S.E. Corner Section 21	21	22
	28	27

- Condition Report Only
- Not Found
- Renewed
- Unrecorded
- Surveyed In
- Referenced Out

Previous Renewals/Surveys, etc. Wofford, Rogers and Chatters  
Cadastral Survey dated 1973-1979, Harvey Wofford's Cadastral  
Survey dated 1983 (Unapproved)

Monument(s) & Accessories Found: (Condition and Source)

Found 1975 B.L.M. Brass Cap set firmly in ground. Also found 13" x 14" x 8" stone with 3 notches on East side and 2 notches on South side buried beside brass cap.


17" Fir, S47W, 8.7' (Scribe Vis.), 1975 BT. Rec. S47 1/4 W, 9.9'

20" Maple, N29E, 42.4' (Scribe Vis.), 1975 BT. Rec. N29 1/2 E, 43.6'

24" Fir, S38E, 39.6' (Scribe Vis.), 1975 BT. Rec. S37 3/4 E, 39.5'

29" Fir, N30W, 54.6' (Scribe Vis.), 1975 BT. Rec. N29 1/2 W, 54.8'

Monument Detail

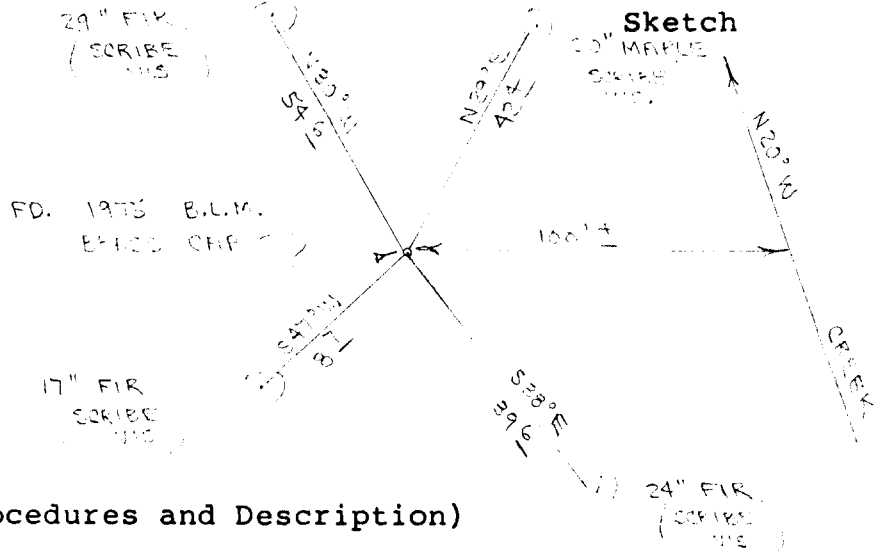

Monument Set (Procedures and Description)

---



---



---



---

New Accessories


None

Location & Comments

Corner lies on steep  
 East slope about 100'  
 West of Creek. Creek  
 bears N30W.

Compass Declination 20 1/2  
 Firm/Agency Roberts  
Surveying Inc.  
 Address 29 West 29th St.  
Eugene, Oregon 97405  
 Party Chief Les Roberts  
 Notes Ted Baker  
 Witness Stu Duce

Surveyor's Seal

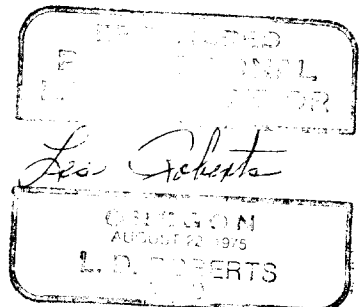

C.S. File No. 58/280<sup>Ab</sup>(N)