

M 96-24

FILED
RECEIVED *BS*

OREGON CORNER RESTORATION FORM

MAR 28 1984


Section 21 Township 22S Range 9W

COUNTY SURVEYOR
DOUGLAS COUNTY, ORE.

County Douglas Date 4-06-83

Corner Designation

West $\frac{1}{4}$ Corner
Section 21

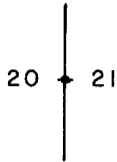

- Condition Report Only
- Not Found
- Renewed
- Unrecorded
- Surveyed In
- Referenced Out

Previous Renewals/Surveys, etc. Wofford, Rogers and Chatters
Cadastral Survey dated 1973-1979.

Monument(s) & Accessories Found: (Condition and Source)

Found 1975 B.L.M. Brass Cap set firmly in ground.


36" Fir Stub, S30W, 13.3' (No Marks) . 1894 BT. Rec. S27W, 18.5'

48" Fir, S52E, 74.6' (Scribe Vis.), 1894 BT. Rec. S54E, 75.2'

24" Fir, N55W, 34.3' (Scar Vis.), 1975 BT. Rec. N55 $\frac{1}{2}$ W, 35.6'

Monument Detail

Sketch

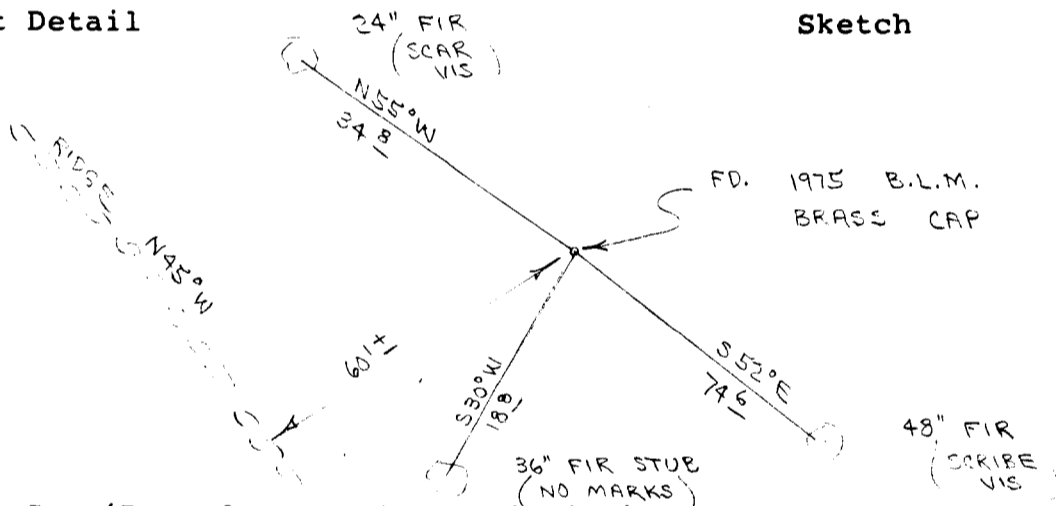

Monument Set (Procedures and Description)

New Accessories

None

Location & Comments

Corner lies on N.E. slope about 60' Easterly of ridge. Ridge bears N45W and S45E

Compass Declination 20 $\frac{1}{2}$

Firm/Agency Roberts Surveying Inc.

Address 29 West 29th St. Eugene, Oregon 97405

Party Chief Les Roberts

Notes Ted Baker

Witness Stu Duce

Surveyor's Seal