

M 96-24

FILED
RECEIVED BS

OREGON CORNER RESTORATION FORM

MAR 28 1984

Section 21 Township 22S Range 2W

COUNTY SURVEYOR
DOUGLAS COUNTY, ORE.

County Douglas Date 4-27-83

Corner Designation

North $\frac{1}{4}$ Corner
Section 21
16
21

- Condition Report Only
- Not Found
- Renewed
- Unrecorded
- Surveyed In
- Referenced Out


Previous Renewals/Surveys, etc. Wofford, Rogers and Chatters
Cadastral Survey dated 1973-1979.

Monument(s) & Accessories Found: (Condition and Source)

Found 1975 B.L.M. Brass Cap set firmly in ground.

- 24" Fir Stump, N24E, 18.6' (No marks), 1874 BT. Rec. N30E, 19.5'
- 36" Maple, S13E, 5.0' (No Marks), 1874 BT. Rec. S15E, 5.3'
- 10" Fir, N38E, 19.8' (Scar Vis.), 1975 BT. Rec. N38 $\frac{1}{2}$ E, 19.8'
- 28" Hemlock, S24W, 31.7' (Scribe Vis.), 1975 BT. Rec. S26 $\frac{3}{4}$ W, 34.3'

Monument Detail

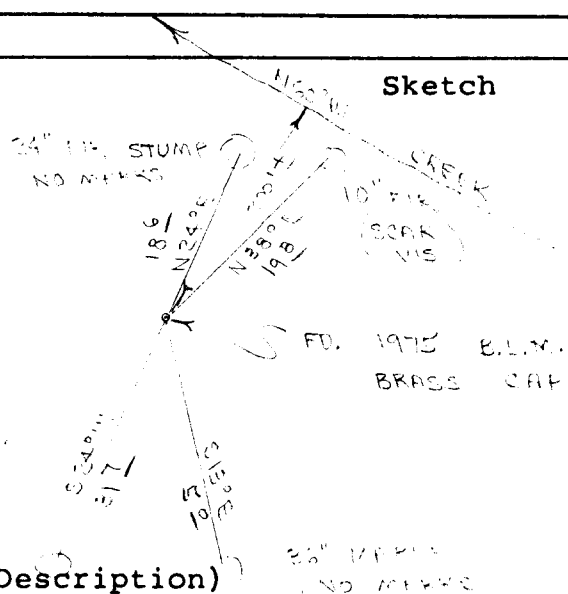

Monument Set (Procedures and Description)

New Accessories

None

Location & Comments

Corner lies on North slope about 200' Southwesterly of Creek. Creek bears N60W

Compass Declination 20 $\frac{1}{2}$
 Firm/Agency Roberts Surveying Inc.
 Address 29 West 29th St. Eugene, Oregon 97405
 Party Chief Les Roberts
 Notes Ted Baker
 Witness Stu Duce

Surveyor's Seal

Les Roberts