

M 96-24

FILED  
RECEIVED *BS*

OREGON CORNER RESTORATION FORM

MAR 28 1984


Section 21 Township 22S Range 9W

COUNTY SURVEYOR  
DOUGLAS COUNTY, ORE.

County Douglas Date 10-12-83

Corner Designation

Center  $\frac{1}{4}$  Corner  
Section 21

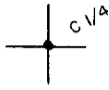

- Condition Report Only
- Not Found
- Renewed
- Unrecorded +
- Surveyed In
- Referenced Out

Previous Renewals/Surveys, etc. None

Monument(s) & Accessories Found: (Condition and Source)


Monument Detail

Sketch



SET  $1\frac{1}{2}$ " x 36"  
IRON PIPE &  
BRASS CAP

9" FIR  
(SCRIBED)

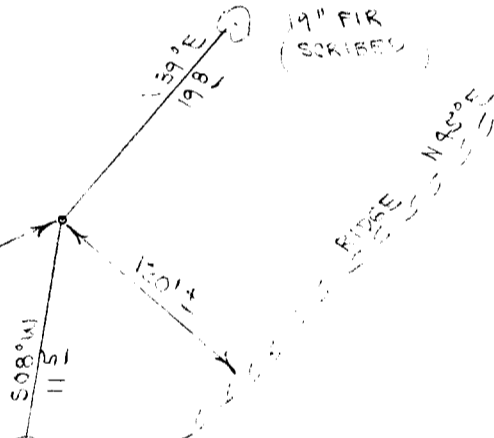

Monument Set (Procedures and Description)

Set  $1\frac{1}{2}$ " x 36" Iron Pipe and Brass Cap. Cap stamped S-T-R, date and P.L.S. No. 1039. Buried orange magnetic marker under 36" pipe. See filed survey for survey procedures.

New Accessories

- 9" Fir, S08W, 11.5' (Scribed/Painted/Brass Washer)
- 19" Fir, N39E, 19.8' (Scribed/Painted/Brass Washer)

Location & Comments

Surveyor's Seal

Corner lies on N.W. slope about 120' Northwesterly of ridge. Ridge bears N45E and S45W

Compass Declination  $20\frac{1}{2}$

Firm/Agency Roberts Surveying Inc.

Address 29 West 29th St. Eugene, Oregon 97405

Party Chief Ted Baker

Notes Stu Duce

Witness

*Leo Roberts*

C.S. File No. 58/280 (M)

F99

C