

M 90-52

FILED
RECEIVED *BS*

MAR 22 1984

OREGON CORNER RESTORATION FORM


Section 22 Township 22S Range 9W

County Douglas Date 9-14-83

COUNTY SURVEYOR
DOUGLAS COUNTY, ORE.

Corner Designation

West $\frac{1}{4}$ Corner
Section 22

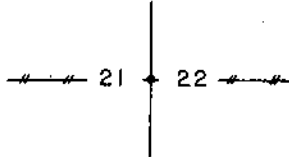

- Condition Report Only
- Not Found
- Renewed
- Unrecorded +
- Surveyed In
- Referenced Out

Previous Renewals/Surveys, etc. Wofford, Rogers and Chatters
Cadastral Survey dated 1973-1979. Harvey Wofford's Cadastral
Survey dated 1983 (Unapproved).

Monument(s) & Accessories Found: (Condition and Source)

Found 1983 B.L.M. Brass Cap set firmly in ground. Found 10" x 12"
x 16" Stone marked "1/4 S" beside cap.

10" Fir, S88E, 26.2' (Scribe Vis.), 1983 BT. Rec. N87E, 25.7'


20" Fir, S39W, 19.0' (Scribe Vis.), 1983 BT. Rec. S36W, 19.1'

Erroneously set B.L.M. Brass Cap, 1975, bears S20° 52' 45" W,
66.15'. 1975 B.L.M. Brass Cap has been removed and reset in the
correct position. The 1975 date has been filed off and restamped
1983.

Monument Detail

BLAZED & POSTED

Sketch

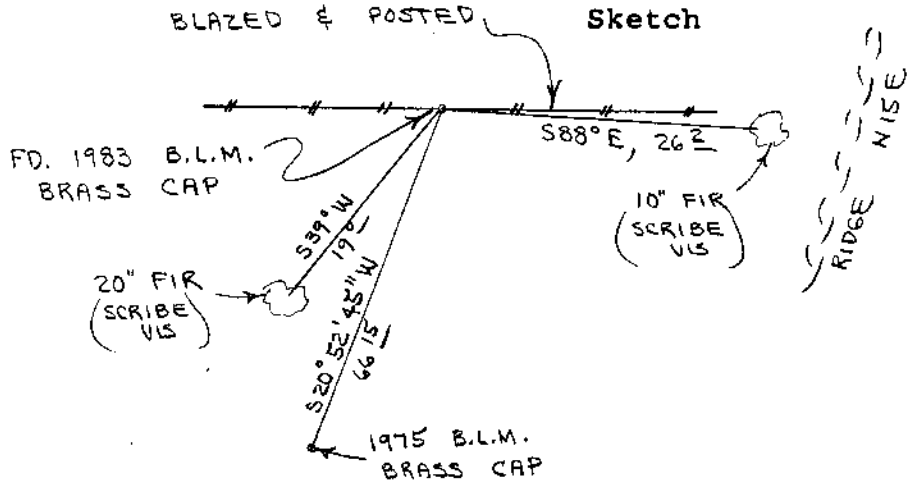

Monument Set (Procedures and Description)

New Accessories

None

Location & Comments

Corner lies on steep West slope about 100' West of North-South ridge. Compass Declination $20\frac{1}{2}$
Firm/Agency Roberts Surveying Inc.
Address 29 West 29th St. Eugene, Oregon 97405
Party Chief Les Roberts
Notes Ted Baker
Witness Stu Duce.

Surveyor's Seal

REGISTERED
PROFESSIONAL
LAND SURVEYOR

Les Roberts

OREGON
AUGUST 22, 1975
L. D. ROBERTS
1039

C.S. File No. 58/280 (u)

#101

0.f.19

of

C