

M 90-52

FILED
RECEIVED *BR*

MAR 22 1984

OREGON CORNER RESTORATION FORM


Section 22 Township 22S Range 9W

County Douglas Date 9-14-83

COUNTY SURVEYOR
DOUGLAS COUNTY, ORE.

Corner Designation

North 1/16 Corner
Section 22

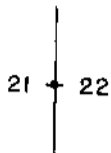

- Condition Report Only
- Not Found
- Renewed
- Unrecorded
- Surveyed In
- Referenced Out


Previous Renewals/Surveys, etc. Wofford, Rogers and Chatters
Cadastral Survey dated 1973-1979. Harvey Wofford's Cadastral
Survey dated 1983 (Unapproved).

Monument(s) & Accessories Found: (Condition and Source)

Found 1983 B.L.M. Brass Cap set firmly in ground.
22" Fir, N61W, 14.8' (Scribe Vis.), 1983 B.T. Rec. N61W, 15.2'
22" Fir, S18E, 40.1' (Scar Vis.), 1975 B.T. Rec. S18E, 40.3'
Erroneously set B.L.M. Brass Cap, 1975, bears S 21° 01' 59" W,
34.05'. 1975 B.L.M. Brass Cap has been removed and reset in the
correst position. The 1975 date has been filed off and restamped
1983.

Monument Detail

22" FIR
(SCRIBE
VIS)

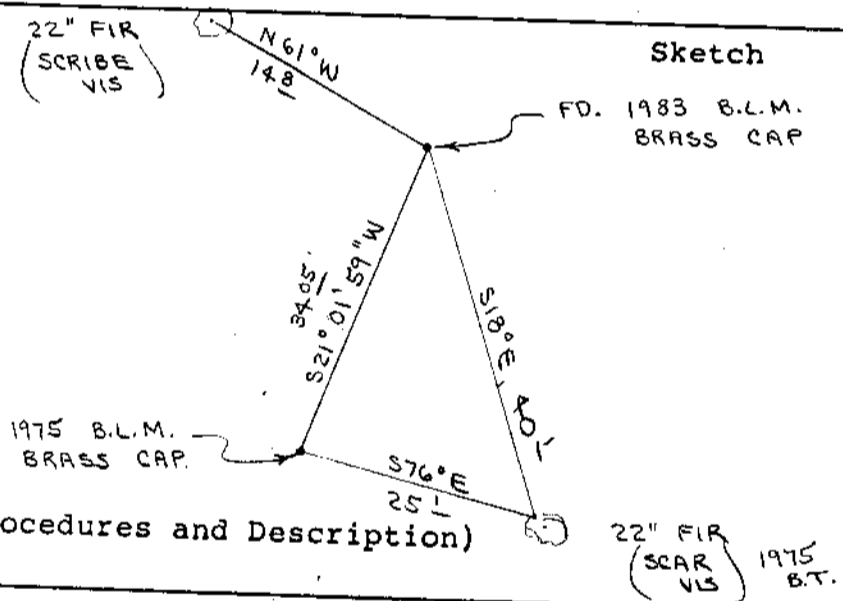

Sketch

Monument Set (Procedures and Description)

New Accessories

None

Location & Comments

Corner lies on South
slope about 110'
South of spur ridge.
Ridge runs S45E and
N45W.

Compass Declination 20½
Firm/Agency Roberts
Surveying Inc.
Address 29 West 29th St.
Eugene, Oregon 97405
Party Chief Ted Baker
Notes Stu Duce
Witness _____

Surveyor's Seal

REGISTERED
PROFESSIONAL
LAND SURVEYOR

L. D. Roberts

OREGON
AUGUST 22, 1975
L. D. ROBERTS
1039

*ok
dem*

C.S. File No. 58/280-5b