

M 90-52

FILED  
RECEIVED *RL*

MAR 22 1984

OREGON CORNER RESTORATION FORM

Section 22 Township 22S Range 9W

COUNTY SURVEYOR  
DOUGLAS COUNTY, ORE.

County Douglas Date 3-25-83

Corner Designation

West 1/16 Corner  
Section 22  
15  
+  
22


- Condition Report Only
- Not Found
- Renewed
- Unrecorded +
- Surveyed In
- Referenced Out

Previous Renewals/Surveys, etc. Wofford, Rogers and Chatters  
Cadastral Survey dated 1973-1979.

Monument(s) & Accessories Found: (Condition and Source)

Found 1975 B.L.M. Brass Cap firmly set in ground.  
9" Fir, N50W, 13.7' (Scar Vis.), 1975 BT. Rec. N51 1/2 W, 13.9'  
10" Fir, S85E, 11.7' (Scar Vis.), 1975 BT. Rec. S4 1/2 E, 11.9'

Monument Detail

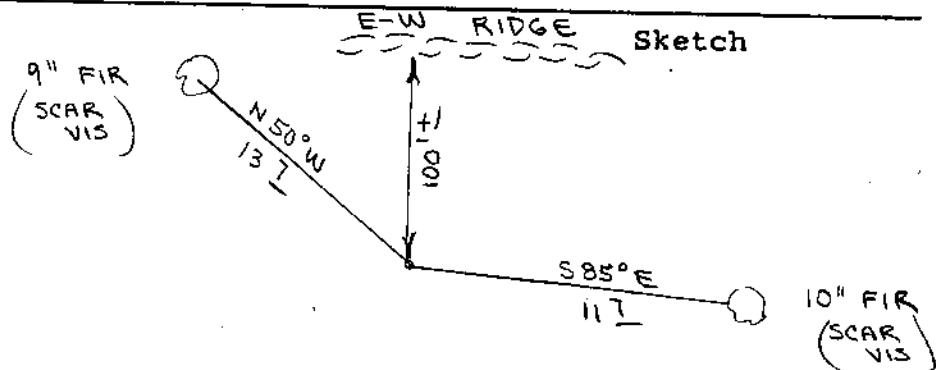

Monument Set (Procedures and Description)

\_\_\_\_\_  
\_\_\_\_\_  
\_\_\_\_\_  
\_\_\_\_\_

New Accessories

None

Location & Comments

Corner lies on South slope about 100' South of main East-West Ridge.  
Compass Declination 20 1/2  
Firm/Agency Roberts Surveying Inc.  
Address 29 West 29th St. Eugene, Oregon 97405  
Party Chief Les Roberts  
Notes Ted Baker  
Witness Stu Duce

Surveyor's Seal

REGISTERED  
PROFESSIONAL  
LAND SURVEYOR

*Les Roberts*

OREGON  
AUGUST 22, 1975  
L. D. ROBERTS  
1039

OK  
Jem