

M 90-52

FILED
RECEIVED *BS*

MAR 22 1984

OREGON CORNER RESTORATION FORM

Section 22 Township 22S Range 9W

County Douglas Date 3-24-83

COUNTY SURVEYOR
DOUGLAS COUNTY, ORE.

Corner Designation

North $\frac{1}{4}$ Corner 15
Section 22 22

- Condition Report Only
- Not Found
- Renewed
- Unrecorded +
- Surveyed In
- Referenced Out

Previous Renewals/Surveys, etc. Wofford, Rodgers and Chatters
Cadastral Survey dated 1973-1979.

Monument(s) & Accessories Found: (Condition and Source)

Found 1975 B.L.M. Brass Cap set firmly in ground. Also found
8" x 10" x 16" Stone marked "1/4S" on West face deposited beside
brass cap.


18" Fir, N18E, 5.1' (Scar Vis.), 1975 BT. Rec. N17E, 5.3'

22" Fir, S15E, 15.3' (Scar Vis.), 1975 BT. Rec. S16E, 17.8'

Monument Detail

18" FIR
(SCAR
VIS)

Sketch

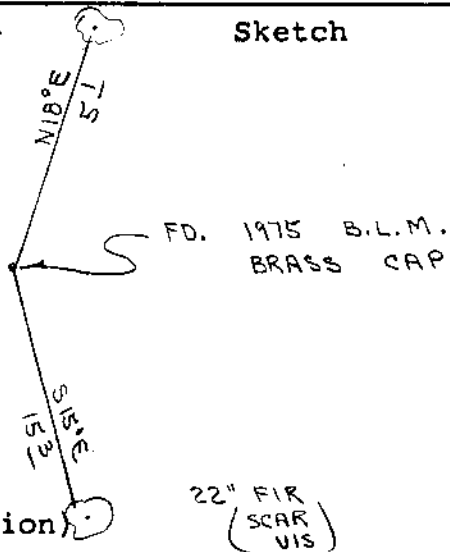

Monument Set (Procedures and Description)


New Accessories

None

Location & Comments

Corner lies on steep South slope. Compass Declination 20 $\frac{1}{2}$
Firm/Agency Roberts
Surveying Inc.
Address 29 West 29th St.
Eugene, Oregon 97405
Party Chief Les Roberts
Notes Ed Roberts
Witness

Surveyor's Seal

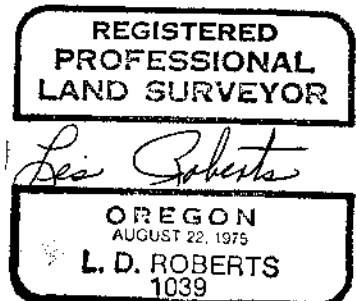

*OK
JCM*

C.S. File No. 58/280-5E