

M 90-52

FILED
RECEIVED *BS*

OREGON CORNER RESTORATION FORM

MAR 22 1984

Section 22 Township 22S Range 9W

COUNTY SURVEYOR
DOUGLAS COUNTY, ORE.

County Douglas Date 3-24-83

Corner Designation

N.E. Corner Section 22	15	14
	22	23

- Condition Report Only
- Not Found
- Renewed
- Unrecorded
- Surveyed In
- Referenced Out

Previous Renewals/Surveys, etc. Wofford, Rogers and Chatters
Cadastral Survey dated 1973-1979, Harvey Wofford's Cadastral
Survey dated 1983 (Unapproved), Vernon Tracy, D.G.S., in 1968.

Monument(s) & Accessories Found: (Condition and Source)

Found 1973 B.L.M. Brass Cap set firmly in ground.

40" Fir, N60E, 18.4' (Bark Scribe), 1874 BT. Rec. N65E, 21.1'


48" Fir, S23W, 67.6' (Scar Vis.) , 1874 BT. Rec. S22W, 66.0'

8" Fir, N31W, 22.6' (Scar Vis.) , 1967 BT. Rec. N31½W, 23.8'

8" Fir, S74E, 60.2' (Scar Vis.) , 1968 BT. Rec. S75E, 60.1'

Monument Detail

Sketch

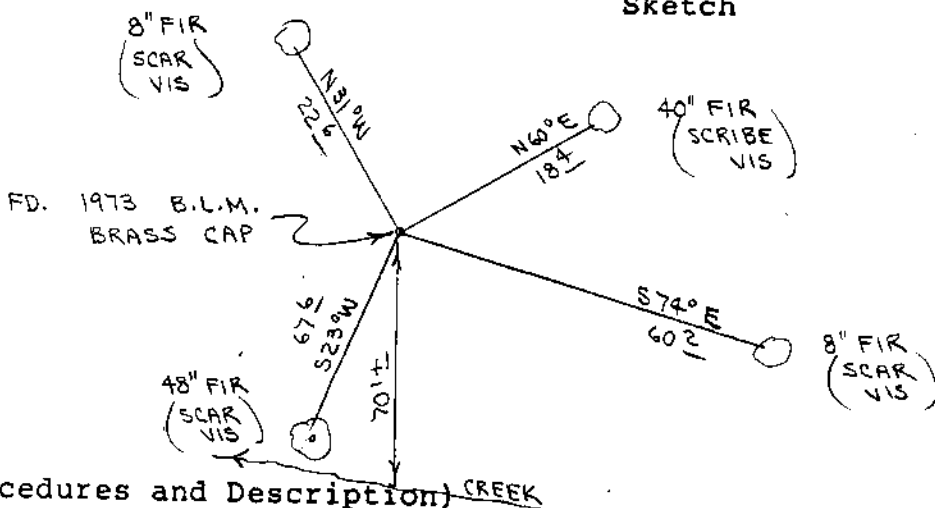

Monument Set (Procedures and Description)

New Accessories

None

Location & Comments

Corner lies on steep South slope about 70' North of creek. Creek bears N75W.

Compass Declination 20½

Firm/Agency Roberts Surveying Inc.

Address 29 West 29th St. Eugene, Oregon 97405

Party Chief Ted Baker

Notes Stu Duce

Witness Buzz Moisan

Surveyor's Seal

