

M 90-52

FILED
RECEIVED *BS*

MAR 22 1984

OREGON CORNER RESTORATION FORM

Section 22 Township 22S Range 9W

County Douglas Date 9-12-83

COUNTY SURVEYOR
DOUGLAS COUNTY, ORE.

Corner Designation

North 1/16 Corner
Section 22 22 + 23

- Condition Report Only
- Not Found
- Renewed
- Unrecorded
- Surveyed In
- Referenced Out


Previous Renewals/Surveys, etc. Wofford, Rogers and Chatters
Cadastral Survey dated 1973-1979. Harvey Wofford's Cadastral
Survey dated 1983 (Unapproved).

Monument(s) & Accessories Found: (Condition and Source)

Found 1983 B.L.M. Brass Cap set firmly in ground.
15" Fir, N36W, 27.5' (Scar Vis.), 1974 BT. Rec. N36W, 28.1'
23" Fir, N49E, 42.2' (Scar Vis.), 1974 BT. Rec. N49E, 42.9'
Erroneously set B.L.M. Brass Cap, 1974, bears N 15° 41' 17" W,
18.45'. 1974 B.L.M. Brass Cap has been removed and reset in the
correct position. The 1974 date has been filed off and brass cap
restamped 1983.

Monument Detail

Sketch

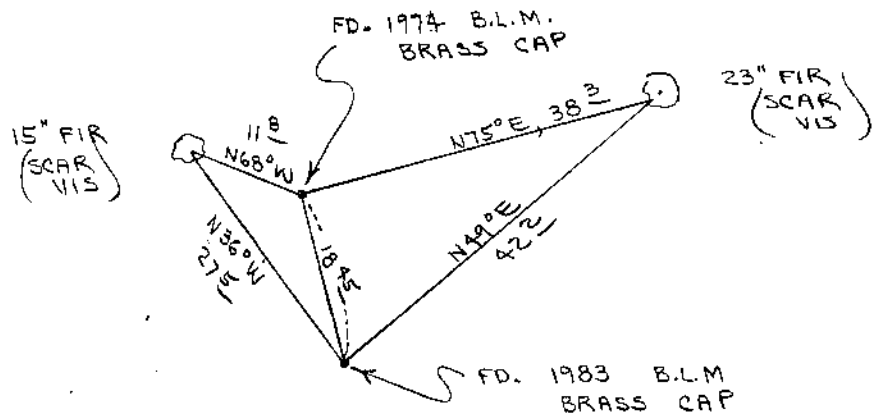

Monument Set (Procedures and Description)


New Accessories

None

Location & Comments

Corner lies on large flat covered with Compass Declination 20 1/2
100-120 year old green timber. Firm/Agency Roberts
Surveying Inc.
Address 29 West 29th St.
Eugene, Oregon 97405
Party Chief Ted Baker
Notes Stu Duce
Witness

Surveyor's Seal

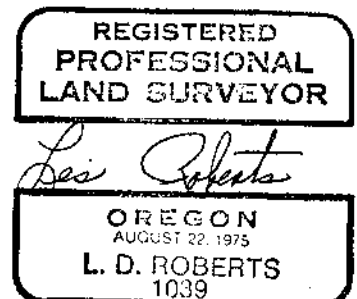

OK dem