

M 90-52

FILED
RECEIVED BS

MAR 22 1984

OREGON CORNER RESTORATION FORM

Section 22 Township 22S Range 9W

County Douglas Date 9-12-83

COUNTY SURVEYOR
DOUGLAS COUNTY, ORE.

Corner Designation

South 1/16 Corner
Section 22

22 + 23


- Condition Report Only
- Not Found
- Renewed
- Unrecorded
- Surveyed In
- Referenced Out

Previous Renewals/Surveys, etc. Wofford, Rogers and Chatters
Cadastral Survey dated 1973-1979. Harvey Wofford's Cadastral
Survey dated 1983 (Unapproved)

Monument(s) & Accessories Found: (Condition and Source)

Found 1983 B.L.M. Brass Cap set firmly in ground.
15" Fir, N18E, 11.3' (Scribe Vis.), 1983 BT. Rec. N19E, 5.9'
22" Fir, N53W, 5.9' (Scribe Vis.), 1983 BT. Rec. N53W, 11.2'
Erroneously set B.L.M. Brass Cap, 1974, bears N 5° 30' 00" W,
50.00'. This 1974 B.L.M. Brass Cap has been removed and reset in
the correct position. The 1974 date has been filed off and brass
cap restamped 1983.

Monument Detail

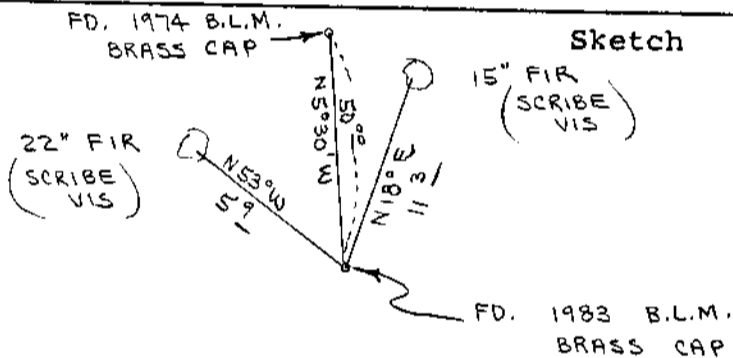

Monument Set (Procedures and Description)

New Accessories

None

Location & Comments

Compass Declination 20 1/2
Firm/Agency Roberts
Surveying Inc.
Address 29 West 29th St.
Eugene, Oregon 97405
Party Chief Ted Baker
Notes Stu Duce
Witness _____

Surveyor's Seal

REGISTERED
PROFESSIONAL
LAND SURVEYOR

L. D. Roberts
OREGON
AUGUST 22, 1975
L. D. ROBERTS
1039

OK
LDM

C.S. File No. 58/200-5J