

M 90-52

FILED
RECEIVED BS

MAR 22 1984

OREGON CORNER RESTORATION FORM
Section 22 Township 22S Range 9W
County Douglas Date 9-12-84 ^{3/30/84} ~~83~~ BS

COUNTY SURVEYOR
DOUGLAS COUNTY, ORE.

Corner Designation

S.E. Corner	22	23
Section 22		
	27	26

- Condition Report Only
- Not Found
- Renewed
- Unrecorded
- Surveyed In
- Referenced Out

Previous Renewals/Surveys, etc. Wofford, Rogers and Chatters
Cadastral Survey dated 1973-1979, Harvey Wofford's Cadastral
Survey dated 1983 (Unapproved)

Monument(s) & Accessories Found: (Condition and Source)

Found 1983 B.L.M. Brass Cap set firmly in ground. Also found 6" x 8" x 10" stone with 2 notches on South and East sides.

30" Fir Stump, N41W, 35.0' (No Marks), 1894 BT. Rec. N41W, 58.1'

46" Fir Snag, N41E, 18.8' (No Marks), 1894 BT. Rec. N42E, 19.1'


48" Fir Snag, S65E, 65.0' (No Marks), 1894 BT. Rec. S55E, 34.3'

11" Fir, N55E, 33.6' (Scribe Vis.), 1983 BT. Rec. N59E, 33.7'

12" Fir, S87E, 33.3' (Scribe Vis.), 1983 BT. Rec. S87E, 33.0'

17" Fir, S76W, 55.9' (Scribe Vis.), 1983 BT. Rec. S76 1/2 W, 56.8'

18" Fir, N88W, 73.2' (Scribe Vis.), 1983 BT. Rec. N87W, 74.6'

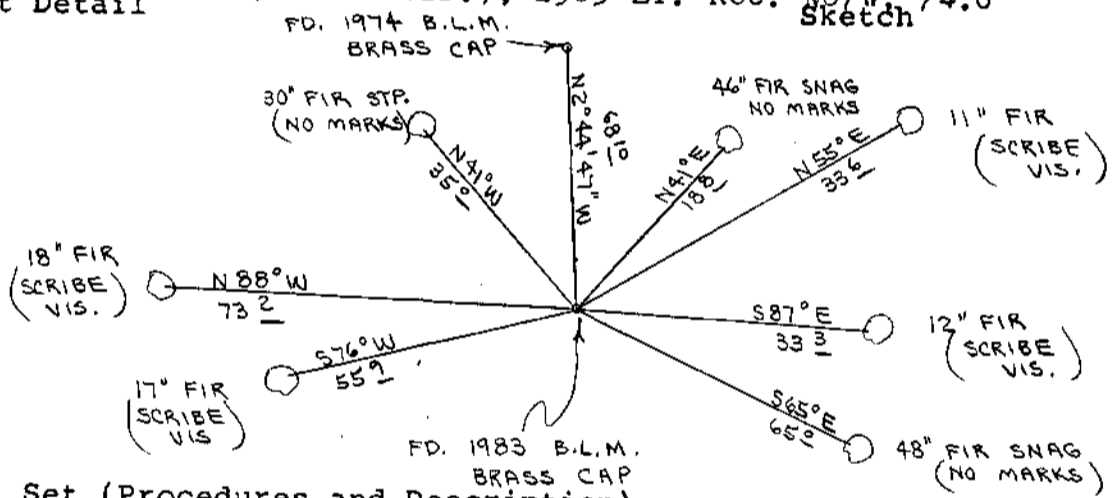

Monument Set (Procedures and Description)

Erroneously set B.L.M. Brass Cap; 1974, bears N2° 44' 47" W, 68.10'. This 1974 B.L.M. Brass Cap has been removed and reset in the correct position. The 1974 date has been filed off and brass cap restamped 1983.

New Accessories

None

Location & Comments

This corner lies in Compass Declination 20 1/2
small hollow on West Firm/Agency Roberts
slope. Corner lies Surveying Inc.
about 530' West of Address 29 West 29th St.
main ridge. Ridge Eugene, Oregon 97405
runs N30E and S30W Party Chief Ted Baker
Notes Stu Duce
Witness

Surveyor's Seal



C.S. File No. 58/280-SK

#100

OK

C