

M 90-52

FILED  
RECEIVED *BS*

OREGON CORNER RESTORATION FORM

MAR 22 1984

Section 22 Township 22S Range 9W

COUNTY SURVEYOR  
DOUGLAS COUNTY, ORE.

County Douglas Date 9-13-83

Corner Designation

East 1/16 Corner 22  
Section 22  
27


- Condition Report Only
- Not Found
- Renewed
- Unrecorded
- Surveyed In
- Referenced Out

Previous Renewals/Surveys, etc. Wofford, Rogers and Chatters  
Cadastral Survey dated 1973-1979. Harvey Wofford's Cadastral  
Survey dated 1983 (Unapproved)

Monument(s) & Accessories Found: (Condition and Source)  
Found 1983 B.L.M. Brass Cap set firmly in ground.  
19" Fir. N34E, 25.7' (Scribe Vis.), 1983 BT. Rec. N34E, 25.7'  
24" Fir. S46E, 46.5' (Scribe Vis.), 1983 BT. Rec. S45 1/2 E, 47.5'  
Erroneously set B.L.M. Brass Cap, 1975, bears N38° 11' E, 52.21'  
(B.L.M. Tie). This 1975 B.L.M. Brass Cap has been removed and  
reset in the correct position. The 1975 date has been filed off  
and brass cap restamped 1983.

Monument Detail

Sketch

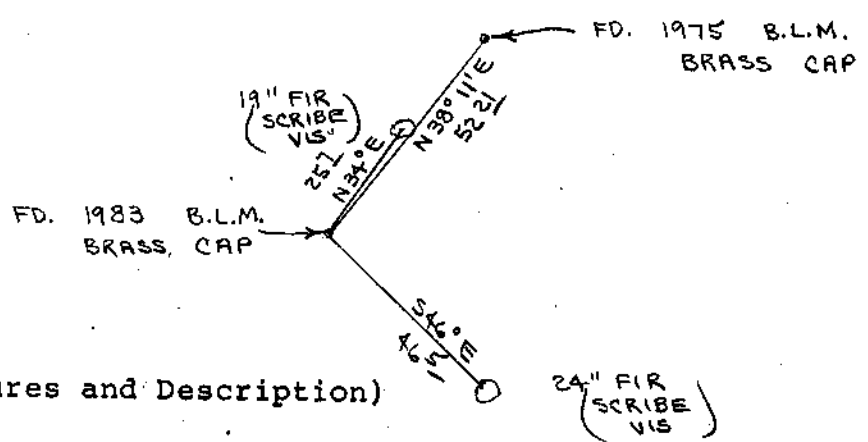

Monument Set (Procedures and Description)

\_\_\_\_\_  
\_\_\_\_\_  
\_\_\_\_\_  
\_\_\_\_\_

New Accessories

None

Location & Comments

Corner lies in bottom of shallow draw. Draw slopes to NE. Compass Declination 20 1/2

Firm/Agency Roberts Surveying Inc.

Address 29 West 29th St. Eugene, Oregon 97405

Party Chief Ted Baker

Notes Stu Duce

Witness

Surveyor's Seal

REGISTERED  
PROFESSIONAL  
LAND SURVEYOR

*Les Roberts*

OREGON  
AUGUST 22, 1975  
L. D. ROBERTS  
1039

*ok  
Lem*