

M 90-52

FILED
RECEIVED BS

MAR 22 1984

OREGON CORNER RESTORATION FORM
Section 22 Township 22S Range 9W
County Douglas Date 9-13-83

COUNTY SURVEYOR
DOUGLAS COUNTY, ORE.

Corner Designation


South 1/4 Corner
Section 22
22
27

- Condition Report Only
- Not Found
- Renewed
- Unrecorded
- Surveyed In
- Referenced Out

Previous Renewals/Surveys, etc. Wofford, Rogers and Chatters
Cadastral Survey dated 1973-1979. Harvey Wofford's Cadastral
Survey dated 1983 (Unapproved)

Monument(s) & Accessories Found: (Condition and Source)
Found 1983 B.L.M. Brass Cap set firmly in ground.
20" Fir, S08E, 13.7' (Scar Vis.), 1975 BT. Rec. S09E, 13.9'
34" Fir, N18E, 43.0' (Scar Vis.), 1975 BT. Rec. N17E, 43.9'
Erroneously set B.L.M. Brass Cap, 1975, bears N 13° 04' 25" E,
34.58'. This 1975 B.L.M. Brass Cap has been removed and reset
in the correct position. The 1975 date has been filed off and
brass cap restamped 1983.

Monument Detail

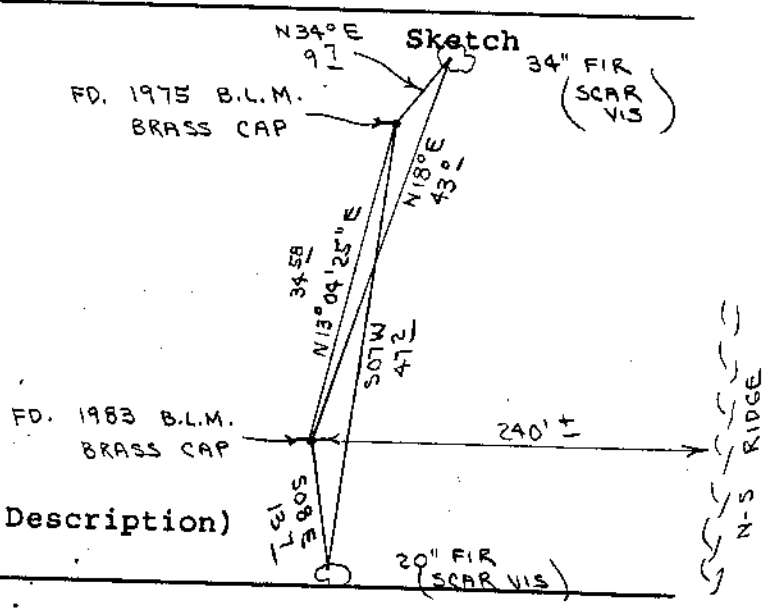

Monument Set (Procedures and Description)

New Accessories

None

Location & Comments

This corner lies on Compass Declination 20 1/2
Northwest slope about Firm/Agency Roberts
240' West on main Surveying Inc.
ridge. Ridge bears Address 29 West 29th St.
North and South Eugene, Oregon. 97405
Party Chief Ted Baker
Notes Stu Duce
Witness _____

Surveyor's Seal

REGISTERED
PROFESSIONAL
LAND SURVEYOR

L. D. Roberts

OREGON
AUGUST 22, 1975
L. D. ROBERTS
1039