

M 90-52

FILED  
RECEIVED *BS*

MAR 22 1984

OREGON CORNER RESTORATION FORM

Section 22 Township 22S Range 9W

County Douglas Date 9-16-83

COUNTY SURVEYOR  
DOUGLAS COUNTY, ORE.

Corner Designation


N.W. 1/16 Corner  
Section 22

- Condition Report Only
- Not Found
- Renewed
- Unrecorded
- Surveyed In
- Referenced Out

Previous Renewals/Surveys, etc. None

Monument(s) & Accessories Found: (Condition and Source)

Monument Detail

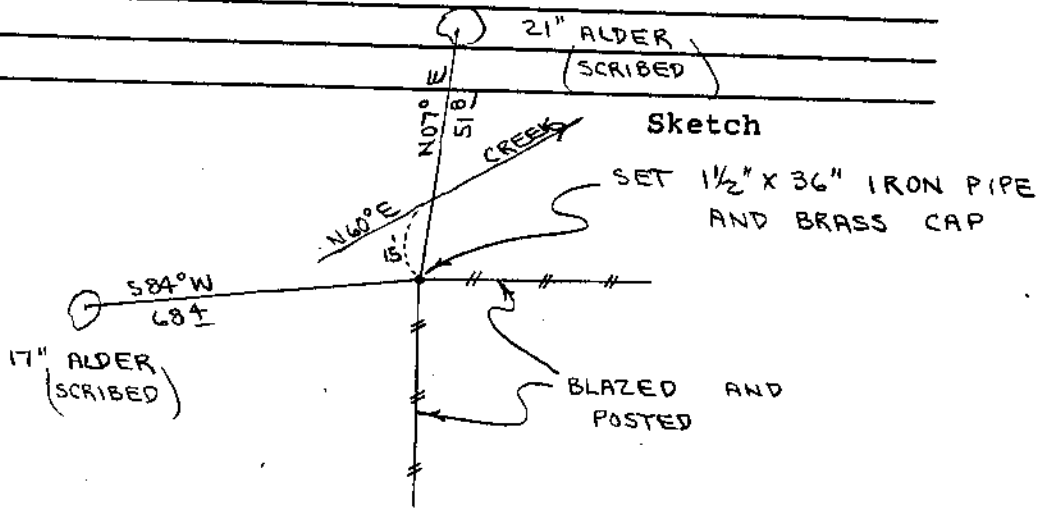

Monument Set (Procedures and Description)

Set  $1\frac{1}{2}$ " x 36" Iron Pipe and Brass Cap. Cap stamped S-T-R, date and P.L.S. No. 1039. Buried orange magnetic marker under 36" pipe. See filed survey for survey procedures.

New Accessories

- 17" Alder, S84W, 68.4' (Scribed/Painted/Brass Washer)
- 21" Alder, N07E, 51.8' (Scribed/Painted/Brass Washer)

Location & Comments

Corner lies about 15' SE of creek.

Compass Declination 20 $\frac{1}{2}$

Firm/Agency Roberts Surveying Inc.

Address 29 West 29th St. Eugene, Oregon 97405

Party Chief Ted Baker

Notes Stu Duce

Witness \_\_\_\_\_

Surveyor's Seal



OK *flm*

C.S. File No. 58/280-50