

M 90-52

FILED
RECEIVED *BS*

MAR 22 1984

OREGON CORNER RESTORATION FORM
Section 22 Township 22S Range 9W
County Douglas Date 9-16-83

COUNTY SURVEYOR
DOUGLAS COUNTY, ORE.

Corner Designation


C.N. 1/16 Corner
Section 22

- Condition Report Only
- Not Found
- Renewed
- Unrecorded
- Surveyed In
- Referenced Out

Previous Renewals/Surveys, etc. None

Monument(s) & Accessories Found: (Condition and Source)

Monument Detail

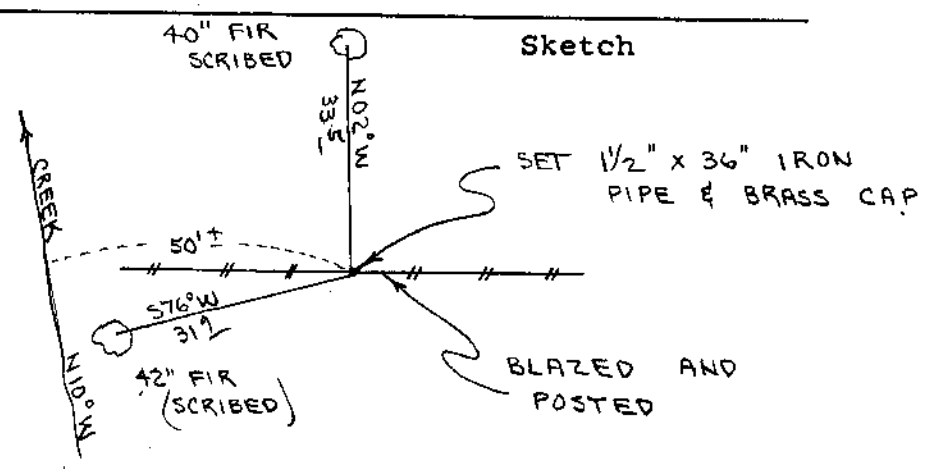

Monument Set (Procedures and Description)

Set $1\frac{1}{2}$ " x 36" Iron Pipe and Brass Cap. Cap stamped S-T-R, date and P.L.S. No. 1039. Buried orange magnetic marker under 36" pipe. See filed survey for survey procedures.

New Accessories

- 40" Fir, No2W, 33.5' (Scribed/Painted/Brass Washer)
- 42" Fir, S76W, 31.9' (Scribed/Painted/Brass Washer)

Location & Comments

Corner lies on NW slope about 50' East of creek. Creek bears N10W and S10E.

Compass Declination 20 $\frac{1}{2}$
 Firm/Agency Roberts Surveying Inc.
 Address 29 West 29th St. Eugene, Oregon 97405
 Party Chief Ted Baker
 Notes Stu Duce
 Witness _____

Surveyor's Seal



C.S. File No. 58/280-5f