

M 90-52

FILED  
RECEIVED *RS*

MAR 22 1984

OREGON CORNER RESTORATION FORM

Section 22 Township 22S Range 9W

COUNTY SURVEYOR  
DOUGLAS COUNTY, ORE.

County Douglas Date 9-19-83

Corner Designation

S.E. 1/16 Corner  
Section 22



- Condition Report Only
- Not Found
- Renewed
- Unrecorded
- Surveyed In
- Referenced Out

Previous Renewals/Surveys, etc. None

Monument(s) & Accessories Found: (Condition and Source)

---



---



---



---




---



---

Monument Detail

Sketch

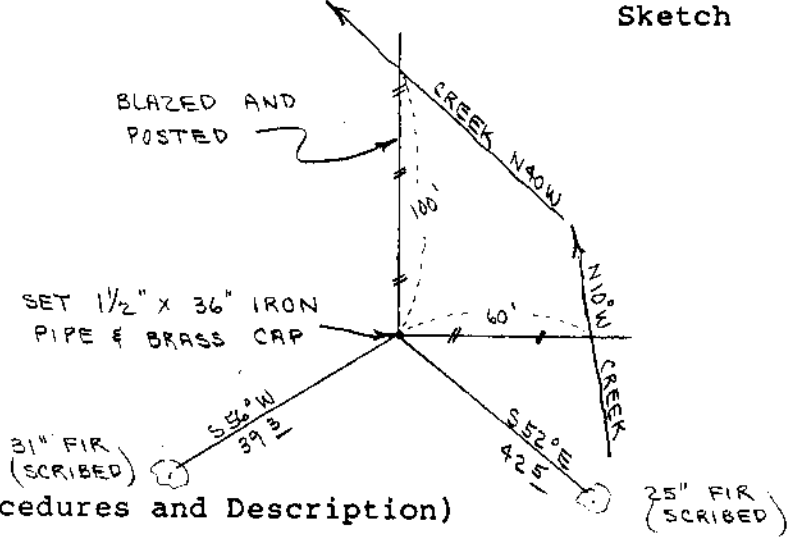

Monument Set (Procedures and Description)

Set  $1\frac{1}{2}$ " x 36" Iron Pipe and Brass Cap. Cap stamped S-T-R, date and P.L.S. No. 1039. Buried orange magnetic marker under 36" pipe. See filed survey for survey procedures.

New Accessories

- 25" Fir, S52E, 42.5' (Scribed/Painted/Brass Washers)
- 31" Fir, S56W, 39.3' (Scribed/Painted/Brass Washer)

Location & Comments

Corner lies on gentle North slope about 60' East of creek

Compass Declination 20 $\frac{1}{2}$

Firm/Agency Roberts Surveying Inc.

Address 29 West 29th St, Eugene, Oregon 97405

Party Chief Ted Baker

Notes Stu Duce

Witness \_\_\_\_\_

Surveyor's Seal

REGISTERED PROFESSIONAL LAND SURVEYOR

*L. D. Roberts*

OREGON  
AUGUST 22, 1975  
L. D. ROBERTS  
1039

ok  
Jen

C.S. File No. 58/280-5s