

M 90-52

FILED
RECEIVED BS

MAR 22 1984

OREGON CORNER RESTORATION FORM


Section 22 Township 22S Range 9W

COUNTY SURVEYOR
DOUGLAS COUNTY, ORE.

County Douglas Date 9-12-~~83~~83 ^{3/30/84}

Corner Designation

East $\frac{1}{4}$ Corner
Section 22

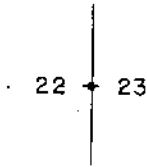

- Condition Report Only
- Not Found
- Renewed
- Unrecorded
- Surveyed In
- Referenced Out


Previous Renewals/Surveys, etc. Wofford, Rogers and Chatters
Cadastral Survey dated 1973-1979. Harvey Wofford's Cadastral
Survey dated 1983 (Unapproved)

Monument(s) & Accessories Found: (Condition and Source)

Found 1983 B.L.M. Brass Cap set firmly in ground.

23" W. Fir, S32E, 37.7' (Scribe Vis.), 1974 BT. Rec. S32E, 38.9'
24" Hemlock, N10W, 70.2' (Scribe Vis.), 1974 BT. Rec. N11W, 70.6'
Erroneously set B.L.M. Brass Cap, 1974, bears N 6° 27' 30" W,
33.48'. This 1974 B.L.M. Brass Cap has been removed and reset in
the correct position. The 1974 date has been filed off and brass
cap restamped 1983

Monument Detail

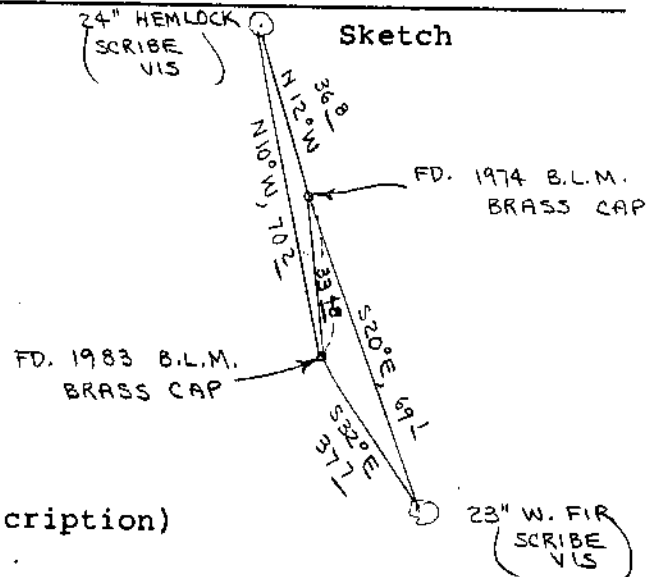

Monument Set (Procedures and Description)

New Accessories

None.

Location & Comments

Corner lies at the base of a steep slope Compass Declination 20 $\frac{1}{2}$
Ground rises sharply Firm/Agency Roberts
to East. Surveying Inc.
Address 29 West 29th St.
Eugene, Oregon 97405
Party Chief Ted Baker
Notes Stu Duce
Witness _____

Surveyor's Seal

REGISTERED
PROFESSIONAL
LAND SURVEYOR

L. D. Roberts
OREGON
AUGUST 22, 1975
L. D. ROBERTS
1039

OK
LLM

C ✓

#102

②