

M 96-26

FILED
RECEIVED BS

MAR 29 1984

OREGON CORNER RESTORATION FORM


Section 35 Township 20S Range 9W

COUNTY SURVEYOR
DOUGLAS COUNTY, ORE.

County Douglas Date 2-19-84

Corner Designation

West $\frac{1}{4}$ Corner
Section 35

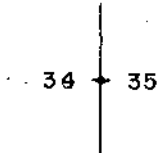

- Condition Report Only
- Not Found
- Renewed
- Unrecorded
- Surveyed In
- Referenced Out

Previous Renewals/Surveys, etc. Thomas A. Tillman and Joseph S. Gawron G.L.O. Survey in 1953-1954.

Monument(s) & Accessories Found: (Condition and Source)


Found 1953 G.L.O. Brass Cap set firmly in ground in mound of stone.

11" Fir, S18E, 15.6' (Scar Vis.), 1953 BT. Rec. S16 $\frac{1}{2}$ E, 16.2'

14" Fir, N41W, 2.0' (Scar Vis.), 1953 BT. Rec. N41W, 2.0'

Monument Detail

Sketch

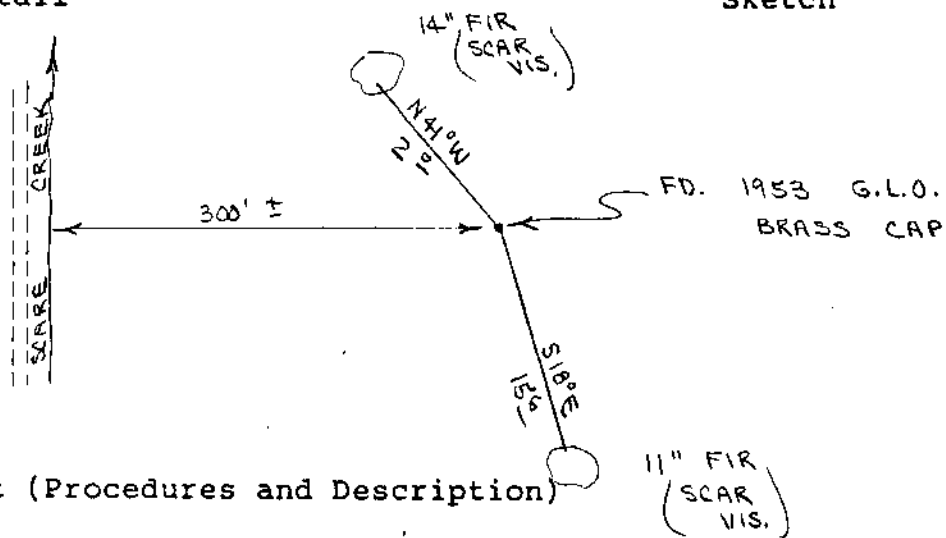

Monument Set (Procedures and Description)

New Accessories

Set metal fence post beside brass cap. Wired survey attention sign to fence post.

Location & Comments

Corner lies on steep and rocky West slope. East of Scare Creek.
Compass Declination 20 $\frac{1}{2}$
Firm/Agency Roberts Surveying Inc.
Address 29 West 29th St. Eugene, Oregon 97405
Party Chief Les Roberts
Notes Ted Baker
Witness Stu Duce

Surveyor's Seal

