

M 96-26

FILED
RECEIVED BS

MAR 29 1984

OREGON CORNER RESTORATION FORM
Section 35 Township 20S Range 9W
County Douglas Date 3-05-84

COUNTY SURVEYOR
DOUGLAS COUNTY, ORE.

Corner Designation

N.E. 1/16 Corner
Section 35




- Condition Report Only
- Not Found
- Renewed
- Unrecorded
- Surveyed In
- Referenced Out

Previous Renewals/Surveys, etc. None

Monument(s) & Accessories Found: (Condition and Source)

Monument Detail

Sketch

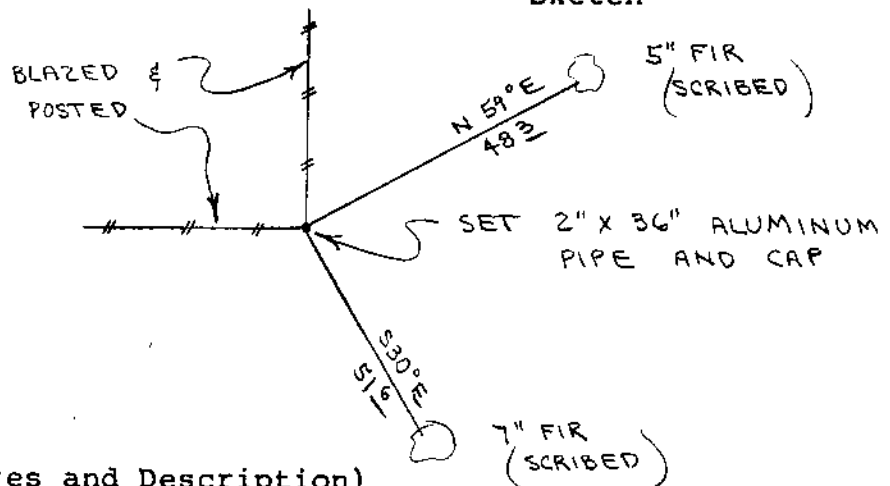

Monument Set (Procedures and Description)

Set 2 1/2" Brass Cap in drill hole in solid rock face. Cap stamped S-T-R, date and P.L.S. No. 1039. See filed survey for survey procedures. Set metal fence post, with land monument survey sign wired to, beside aluminum pipe.

New Accessories

- 5" Fir, N59E, 48.3' (Scribed/Painted/Brass Washer)
- 7" Fir, S30E, 51.6' (Scribed/Painted/Brass Washer)

Location & Comments

Corner lies on steep Compass Declination 20 1/2
Northeast slope about Firm/Agency Roberts
130' West of draw. Surveying Inc.
Address 29 West 29th St.
Eugene, Oregon 97405
Party Chief Ted Baker
Notes Stu Duce
Witness Buzz Moisan

Surveyor's Seal

