

M 96-20

FILED

RECEIVED

AS

MAR 22 1984

OREGON CORNER RESTORATION FORM

Section 26 Township 20S Range 9W

County Douglas Date 3-13-84

COUNTY SURVEYOR  
DOUGLAS COUNTY, ORE.

Corner Designation

|             |    |    |
|-------------|----|----|
| S.W. Corner | 27 | 26 |
| Section 26  | 34 | 35 |

- Condition Report Only
- Not Found
- Renewed
- Unrecorded
- Surveyed In
- Referenced Out

Previous Renewals/Surveys, etc. Thomas A. Tillman and Joseph S. Gawron G.L.O. Survey in 1953 - 1954. Jelley and Bill Glenn Survey in 1963

Monument(s) & Accessories Found: (Condition and Source)

Found 1953 G.L.O. Brass Cap set firmly in ground. Found steel fence post set by Jelley and Glenn in 1967 beside Brass Cap.

Wired survey attention sign to steel fence post.

18" Fir, S11W, 57.4' (Scar Vis.), 1953 BT. Record S11 1/4 W, 57.4'

25" Fir, N45W, 50.2' (Scar Vis.), 1953 BT. Record N45 1/4 W, 50.2'


25" Fir, S84E, 25.2' (Scar Vis.), 1953 BT. Record S833/4E, 25.1'

30" Fir, N83E, 27.6' (Scar Vis.), 1953 BT. Record N83 3/4E, 28.4'

Monument Detail

Sketch

25" FIR (SCAR VIS.)

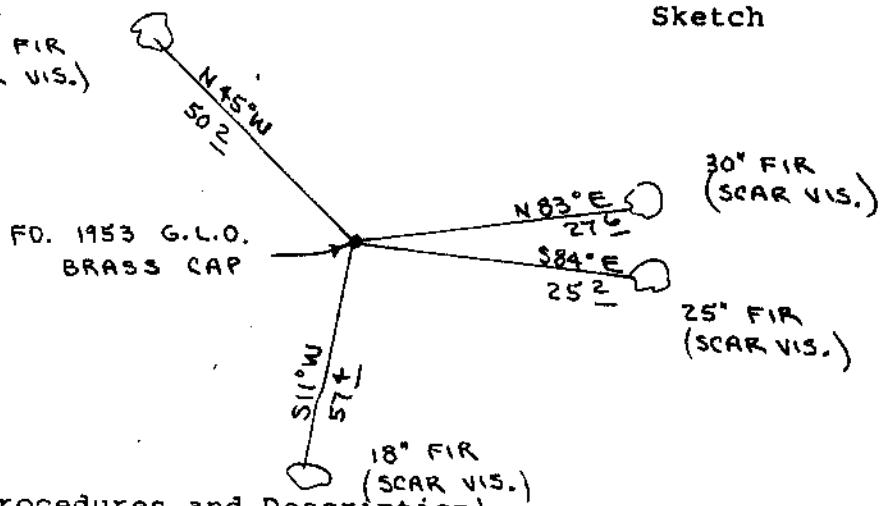

Monument Set (Procedures and Description)

---



---



---



---

New Accessories

None

Location & Comments

Corner lies on South- Compass Declination 20 1/2

West slope about 320' Firm/Agency Roberts

Northeasterly of Surveying Inc.

Smith river road. Address 29 West 29th St.

Corner lies in 100- Eugene, Oregon 97405

120 year old green Party Chief Les Roberts

timber. Notes Ted Baker

Witness Stu Duce

Surveyor's Seal



C.S. File No. 58/280-1A (u)