

M 96-20

FILED
RECEIVED *BS*

OREGON CORNER RESTORATION FORM

MAR 22 1984

Section 26 Township 20S Range 9W

COUNTY SURVEYOR
DOUGLAS COUNTY, ORE.

County Douglas Date 2-13-84

Corner Designation

East 1/4 Corner
Section 26 26.25

- Condition Report Only
- Not Found
- Renewed
- Unrecorded
- Surveyed In
- Referenced Out


Previous Renewals/Surveys, etc. Thomas A. Tillman and Joseph S. Gawron G.L.O. Survey in 1953-1954. Jelley and Bill Glenn Survey in 1967. County renewal #12 in 5-15-69

Monument(s) & Accessories Found: (Condition and Source)

Found 1954 G.L.O. Brass Cap set firmly in ground. Found steel fence post set by Jelley and Glenn in 1967 beside brass cap.
48" Fir Stump, N49W, 16.1' (Scribe Vis.), 1891 BT. Record N51W, 13.2'. This BT was rescribed by cadastral surveyor in 1967.
57" Fir Stump, N83E, 30.6' (Scar Vis.), 1891 BT. Record N83E, 29.7'. Both BT's set by cadastral surveyor in 1954 were destroyed by logging. I did not look for 12" Cedar BT set by Douglas County in 1969.

Monument Detail

Sketch

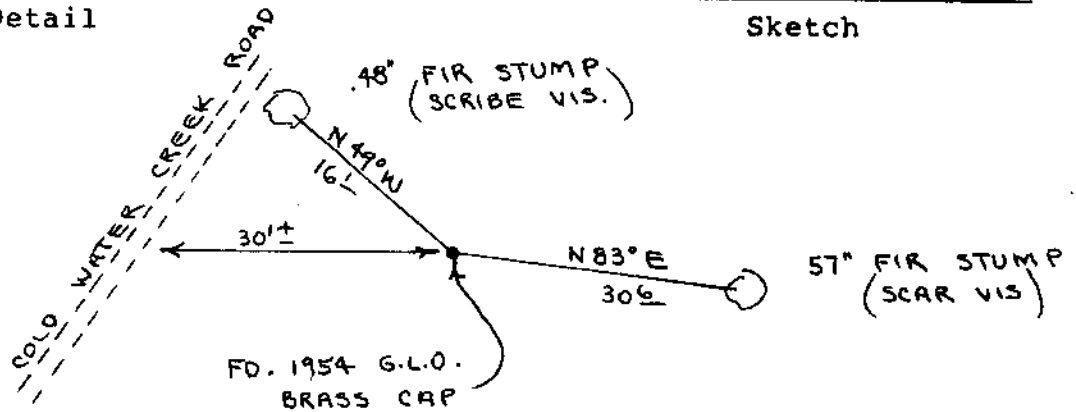

Monument Set (Procedures and Description)

New Accessories

wired survey attention sign to steel fence post.

Location & Comments

This corner lies on Compass Declination 20 1/2
gentle South slope Firm/Agency Roberts
in old logging unit Surveying Inc.
covered with 15-20 Address 29 West 29th St.
year old reproduction. Eugene, Oregon 97504
Corner lies 30 feet Party Chief Les Roberts
Easterly of Cold Water Notes Ted Baker
Creek Road Witness Stu Duce

Surveyor's Seal

REGISTERED
PROFESSIONAL
LAND SURVEYOR

Les Roberts
OREGON
AUGUST 20, 1975
L. D. ROBERTS
1039

C.S. File No. 58/200-7d