

M 96-20

FILED RECEIVED *BS*

MAR 22 1984

OREGON CORNER RESTORATION FORM


Section 26 Township 20S Range 9W

County Douglas Date 3-02-84

COUNTY SURVEYOR DOUGLAS COUNTY, ORE.

Corner Designation

S.W. 1/16 Corner Section 26

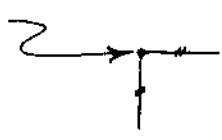


- Condition Report Only
- Not Found
- Renewed
- Unrecorded
- Surveyed In
- Referenced Out

Previous Renewals/Surveys, etc. None

Monument(s) & Accessories Found: (Condition and Source)

Monument Detail

Sketch

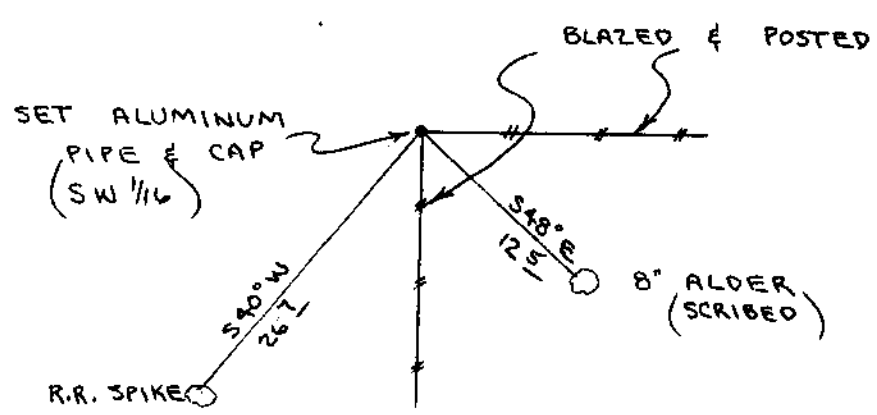

Monument Set (Procedures and Description)

Set 2" x 36" Aluminum pipe and cap. Cap stamped S-T-R, date and P.L.S. No. 1039. See filed survey for survey procedures. Buried purple magnetic marker under 36" pipe.

New Accessories

- 8" Alder, S48E, 12.5' (Bark Scribed/Painted Red/Brass Washer)
- Set R.R. Spike in drill hole in rock face for bearing object. S40W, 26.7' to spike.
- Set metal fence post, with land survey monument sign wired to, beside aluminum pipe.

Location & Comments

Corner lies on old slide area in small draw sloping North-westerly. Ground is very steep and rocky to North and West.

Compass Declination 20 1/2
 Firm/Agency Roberts Surveying Inc.
 Address 29 West 29th St. Eugene, Oregon 97405
 Party Chief Ted Baker
 Notes Stu Duce
 Witness Buzz Moisan

Surveyor's Seal



C.S. File No. 58/280 ^{1h} (~)