

M 96-20

FILED  
RECEIVED *BS*  
MAR 22 1984

OREGON CORNER RESTORATION FORM

Section 26 Township 20S Range 9W  
County Douglas Date 3-05-84

COUNTY SURVEYOR  
DOUGLAS COUNTY, ORE.

Corner Designation

S.E. 1/16 Corner  
Section 26




- Condition Report Only
- Not Found
- Renewed
- Unrecorded
- Surveyed In
- Referenced Out

Previous Renewals/Surveys, etc. None

Monument(s) & Accessories Found: (Condition and Source)

Monument Detail

Sketch

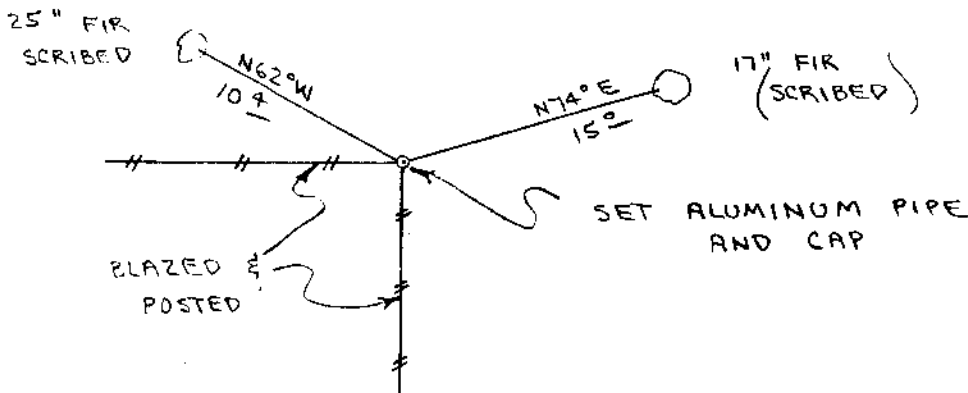

Monument Set (Procedures and Description)

Set 2" x 36" Aluminum pipe and cap. Cap stamped S-T-R, date and P.L.S. No. 1039. Buried purple magnetic marker under 36" pipe. See filed survey for survey procedures.

New Accessories

17" Fir, N74E, 15.0' (Scribed/Painted Red/Brass Washer)  
25" Fir, N62W, 10.4' (Scribed/Painted Red/Brass Washer)  
Set metal fence post, with land survey monument sign wired to, beside aluminum pipe.

Location & Comments

Corner lies on South slope in 100-120 year old green timber. Compass Declination 20 1/2  
Firm/Agency Roberts Surveying Inc.  
Address 29 West 29th St. Eugene, Oregon 97405  
Party Chief Ted Baker  
Notes Stu Duce  
Witness Buzz Moisan

Surveyor's Seal



C.S. File No. 58/280 (13)