

INITIAL POINT OF SURVEY
BASIS OF BEARINGS
N 89° 56' 35" W 1348.96'
1/16 25' BRASS CAP

SECTION CORNER - S25, S26, S35, S36
Found stump and accessories of record
Found RM N 29° 38' E 9.9 feet.
Found RM N 59° 18' W 10.9 feet.

FILED ✓
RECEIVED ✓


FEB 3 1983

COUNTY SURVEYOR
DOUGLAS COUNTY, ORE.
B.S.

**COUNTY SURVEYORS FILE DATA
DO NOT REMOVE FROM OFFICE**

(620 39.8 CA)
N 0° 50' 24" E 2621.42'
1308.12'

N 1/16 - S35, S36, T22S, R10W, 1982, PLS 1093
Set 1 1/4" x 36" I. P. with 2 1/2" Brass Cap marked as above
Scribed 12" fir S47 1/2° W 18.1 Feet.
Scribed 7" Fir S02 1/2° W 36.3 Feet.

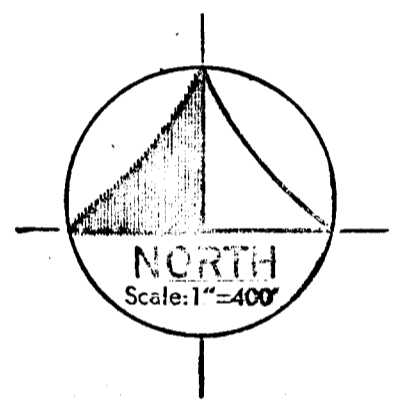

1/4 - S35, S36
Found Brass Cap and accessories of record
1970 BLM

This survey was conducted to locate and mark the lines defining International Paper Company's ownership along a portion of the West Line of Section 36, T 22 S, R 10 W. All controlling corners were found as shown and the 1/16 corner was established in the prescribed manner. Bearings are based on C. S. File M 93-14.

All distances to bearing trees were measured to the side and center of the tree at the root crown. All bearings to accessories are magnetic; mean magnetic variation is 20° East.

| | |
|--|--|
| PLANTS & ASSOCIATES PROFESSIONAL ENGINEERS & LAND SURVEYORS 54 CENTENNIAL LOOP, EUGENE, OREGON (503) 686-9211 510 KINGWOOD STREET, FLORENCE, OREGON (503) 997-8411 | |
| PROJECT | BOUNDARY SURVEY |
| CLIENT | INTERNATIONAL PAPER CO. |
| LOCATION | NW 1/4, SECTION 36, T22S, R10W, W.M. DOUGLAS COUNTY, OREGON |
| DRAWN BY: EMW | JANUARY 13, 1983 |

REGISTERED PROFESSIONAL LAND SURVEYOR
Eugene M. Wobbe
OREGON
JULY 30, 1976
EUGENE M. WOBBE
1093