


T. 22-5 S B SW 1/4 SE 1/4
(DC)

Part of Drain's Addition to Drain

FILED
RECEIVED

MAR 21 1984

COUNTY SURVEYOR
DOUGLAS COUNTY, ORE.

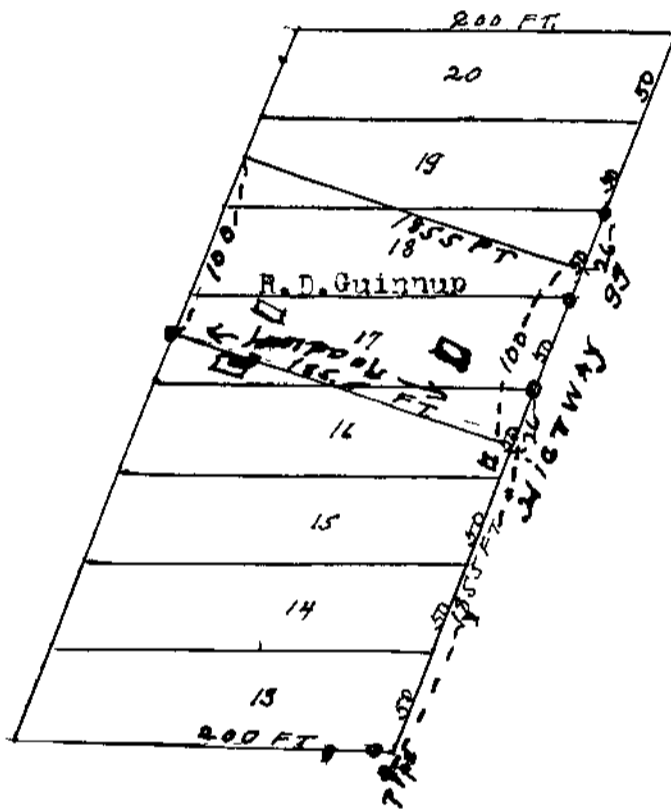

REGISTERED
OREGON
LAND SURVEYOR

O. F. Thiel

MARCH 10 944
OSCAR F THIEL
4

scale 1" = 100 FT