

M 96-41

FILED  
RECEIVED 2/8

APR 19 1984

OREGON CORNER RESTORATION FORM

Section 32 Township 19S Range 7W

County DOUGLAS/LANE Date 2/84

COUNTY SURVEYOR  
DOUGLAS COUNTY, ORE.

Corner Designation

SOUTH 1/4 CORNER  
SECTION 32 ONLY

- Condition Report Only
- Not Found
- Renewed
- Unrecorded
- Surveyed In
- Referenced Out

Previous Renewals/Surveys, etc.

1949 GLO SURVEY BY NORMAN D PRICE

Monument(s) & Accessories Found: (Condition and Source)

FOUND: 1" IRON PIPE WITH GLO BRASS CAP "1949"  
AND ETCHED STONE ALONGSIDE


67" F.I.R., S60E, 34' (RECORD, S10E, 50' LKS) ORIGINAL B.T.

39" F.I.R., N33W, 7' (RECORD, N30W, 10' LKS) ORIGINAL B.T.

37" F.I.R., N61E, 69' (RECORD, N59E, 105' LKS) 1949 B.T.

Monument Detail

Sketch

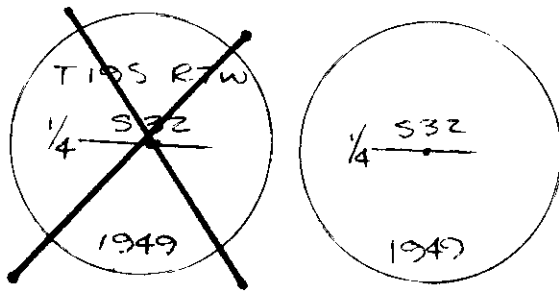

REVISED 4/10/84  
(L.D.P.)

Monument Set (Procedures and Description)

\_\_\_\_\_  
\_\_\_\_\_  
\_\_\_\_\_

New Accessories

\_\_\_\_\_  
\_\_\_\_\_  
\_\_\_\_\_

Location & Comments

Surveyor's Seal

Compass Declination 20°  
 Firm/Agency DELL BAKER  
LAND SURVEYING, INC.  
 Address 12627 LAWRENCE ST.  
EUGENE OREGON 97401  
 Party Chief DAN BAKER  
 Notes \_\_\_\_\_  
 Witness DARYL STANLEY

*[Handwritten Signature]*