

M 96-41

FILED
RECEIVED *h*

APR 19 1984

OREGON CORNER RESTORATION FORM

Section 32 Township 19S Range 7W

COUNTY SURVEYOR
DOUGLAS COUNTY, ORE.

County Douglas/LANE Date 2/84

Corner Designation

SOUTHWEST CORNER
OF SECTION 32
STANDARD SECTION CORNER

- Condition Report Only
- Not Found
- Renewed
- Unrecorded
- Surveyed In
- Referenced Out

Previous Renewals/Surveys, etc. _____

1949 GLO SURVEY BY NORMAN D. PRIKE

Monument(s) & Accessories Found: (Condition and Source)



FOUND: 2" IRON PIPE WITH GLO BRASS CAP "1949"
AND STONE ALONG SIDE

44" FIE, N84°E, 45.8 (RECORD N82°4'E, 711ks) 1949 B.T.

29" FIE, N12°W, 59.5 (RECORD N13 1/2°W, 911ks) 1949 B.T.

Monument Detail

Sketch

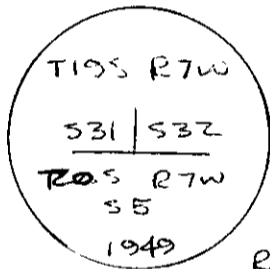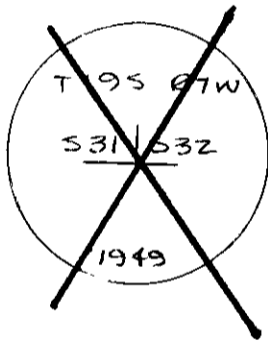

REVISED 4/10/84
EWB

Monument Set (Procedures and Description)

New Accessories

Location & Comments

Surveyor's Seal

Compass Declination 20°
 Firm/Agency PEEL BAKER
LAND SURVEYING, INC.
 Address 1262 LAWRENCE ST
EUGENE OREGON 97401
 Party Chief DAN BAKER
 Notes _____
 Witness DARYL STANLEY

