

M 96-41

FILED
RECEIVED *lf*

APR 19 1984

OREGON CORNER RESTORATION FORM

Section 5 Township 20S Range 7W

COUNTY SURVEYOR
DOUGLAS COUNTY, ORE.

County Douglas/LANE Date 2/84

Corner Designation

CLOSING SECTION CORNER
BETWEEN SECTIONS 4 AND 5

- Condition Report Only
- Not Found
- Renewed
- Unrecorded
- Surveyed In
- Referenced Out

Previous Renewals/Surveys, etc.

1979 GLO SURVEY BY NORMAN D. PRILE
AND 1977 BLM SURVEY BY BLM CADASTRAL SURVEY

Monument(s) & Accessories Found: (Condition and Source)



FND. 2 1/2" IRON PIPE WITH BLM BRASS CAP "1977"
ALSO FOUND 1" IRON ROD ~~58~~ (NORTH 1.44 FEET)

10" FID, S25°E, 9' (RECORD, S31 1/2°E 151KS) 1977 B.T.
S73°W S62°W

9" FID, ~~S73°E~~, 5' (RECORD, ~~S68°E~~, 101KS) 1977 B.T.

Monument Detail

Sketch

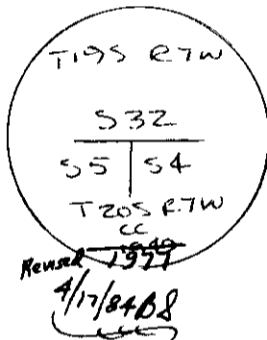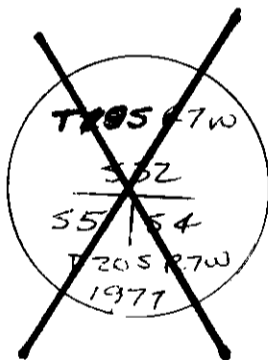

Revised 4/10/84
D.W.B.

Monument Set (Procedures and Description)

New Accessories

Location & Comments

Surveyor's Seal

Compass Declination 20°
 Firm/Agency DEEL BAKER
LAND SURVEYING, INC.
 Address 1262 LAWRENCE ST
EUGENE OREGON 97401
 Party Chief DAN BAKER
 Notes _____
 Witness DARYL STANLEY

