

M 97-51

2

FILED
RECEIVED *BS*

NOV 2 1984

OREGON CORNER RESTORATION FORM

Section 3 Township 21S Range 8W

COUNTY SURVEYOR
DOUGLAS COUNTY, ORE.

County DOUGLAS Date 10/12/84

Corner Designation

S 1/16 CORNER 54 | 53


- Condition Report Only
- Not Found
- Renewed
- Unrecorded
- Surveyed In
- Referenced Out

Previous Renewals/Surveys, etc. _____

Monument(s) & Accessories Found: (Condition and Source)

Monument Detail

Sketch

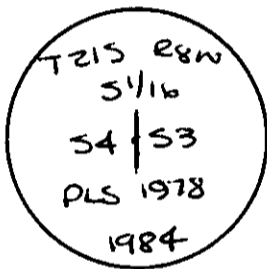

Monument Set (Procedures and Description)

2 1/2" ALUMINUM MONUMENT (I.P.Co.)

WITH MAGNET IN BASE

New Accessories

7" F.I.R., N 20° E, 14.2 FT. (SCRIBED S 1/16 53 BT)

7" F.I.R., S 32 1/2° W, 11.9 FT. (SCRIBED S 1/16 54 BT)

Location & Comments

Surveyor's Seal

Compass Declination 20°

Firm/Agency PEEL BAKER

LAND SURVEYING, INC


Address 1762 LAWRENCE

EGGERS, OREGON

Party Chief DAN BAKER

Notes _____

Witness DARYL STANLEY

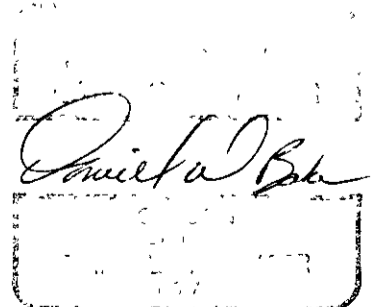

C.S. File No. 58/282(N)

3b
C