

M 97-51

FILED  
RECEIVED *BS*

NOV 2 1984

OREGON CORNER RESTORATION FORM

Section 3 Township 21S Range 8W  
County DOUGLAS Date 10/12/84

COUNTY SURVEYOR  
DOUGLAS COUNTY, ORE.

Corner Designation

CENTER SOUTH 1/16 CORNER


- Condition Report Only
- Not Found
- Renewed
- Unrecorded
- Surveyed In
- Referenced Out

Previous Renewals/Surveys, etc. \_\_\_\_\_

Monument(s) & Accessories Found: (Condition and Source)

Monument Detail

Sketch

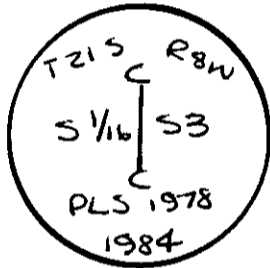

Monument Set (Procedures and Description)

2 1/2" ALUMINUM MONUMENT (I.P. Co.)  
WITH MAGNET IN BASE

New Accessories


34" FIR, N25°E, 34.6 FT. (SCRIBED CS 1/16 S3 BT)

56" FIR, S48°E, 20.6 FT (SCRIBED CS 1/16 S3 BT)

Location & Comments

Surveyor's Seal

Compass Declination 20°  
 Firm/Agency PEEL BAKER  
LAND SURVEYING, INC.  
 Address 1262 LAWRENCE  
EUGENE, OREGON  
 Party Chief DAN BAKER  
 Notes \_\_\_\_\_  
 Witness DARYL STANLEY

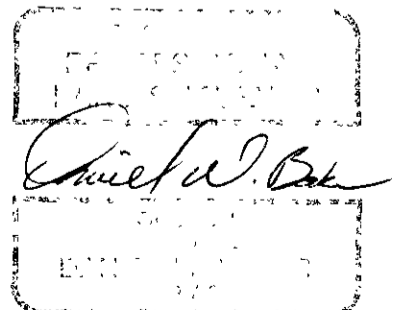

C.S. File No. 58/282<sup>30</sup>(N)