

M 97-51

4

FILED
RECEIVED *BS*

NOV 2 1984

OREGON CORNER RESTORATION FORM

Section 10 Township 21S Range 8W

COUNTY SURVEYOR
DOUGLAS COUNTY, ORE.

County DOUGLAS Date 10/12/84

Corner Designation

CENTER 1/4 CORNER


- Condition Report Only
- Not Found
- Renewed
- Unrecorded
- Surveyed In
- Referenced Out

Previous Renewals/Surveys, etc. _____

Monument(s) & Accessories Found: (Condition and Source)

Monument Detail

Sketch

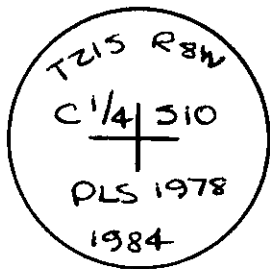

Monument Set (Procedures and Description)

2 1/2" ALUMINUM MONUMENT (I.P. Co.)
WITH MAGNET IN BASE

New Accessories


23" F.I.R., S 78° E, 51.6 FT. (SCRIBED C 1/4 S10 BT)

27" F.I.R., S 20 1/2° W, 9.5 FT. (SCRIBED C 1/4 S10 BT)

Location & Comments

Surveyor's Seal

Compass Declination 20°
 Firm/Agency PEEL BAKER
LAND SURVEYING, INC
 Address 1262 LAWRENCE
EUGENE, OREGON
 Party Chief DAN BAKER
 Notes _____
 Witness DARYL STANLEY

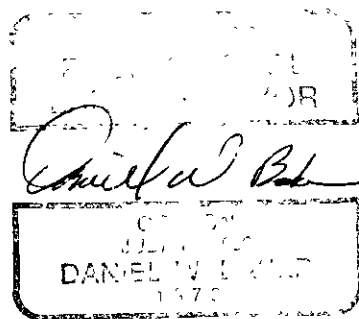

C.S. File No. 58/289 (N) ^{3d}