

M 97-51

FILED  
RECEIVED 88

NOV 2 1984

OREGON CORNER RESTORATION FORM

Section 10 Township 21S Range 8W

County DOUGLAS Date 10/12/84

COUNTY SURVEYOR  
DOUGLAS COUNTY, ORE.

Corner Designation

NORTH 1/16 CORNER S10/S11


- Condition Report Only
- Not Found
- Renewed
- Unrecorded
- Surveyed In
- Referenced Out

Previous Renewals/Surveys, etc.

Monument(s) & Accessories Found: (Condition and Source)

Monument Detail

Sketch

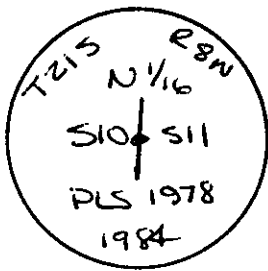

Monument Set (Procedures and Description)

2 1/2" ALUMINUM MONUMENT (I.P.G.)  
WITH MAGNET IN BASE

New Accessories


32" FIR STUMP, S15°W, 15.4 TO R.R. SPIKE IN  
CENTER OF STUMP (SCRIBED N 1/16 S10 BT)

33" FIR, N 54 1/2° W, 23° FT. (SCRIBED N 1/16 S10 BT)

Location & Comments

Surveyor's Seal

Compass Declination 20°  
 Firm/Agency PEEL BAKER  
LAND SURVEYING, INC.  
 Address 1262 LAWRENCE  
EUGENE OREGON  
 Party Chief DAN BAKER  
 Notes \_\_\_\_\_  
 Witness DARYL STANLEY

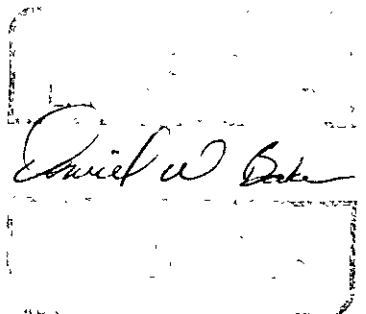

C.S. File No. 58/289(N)

5

3E  
C